RASTER

PARENT PARCEL: 09-00-075-105-078, 09-00-075-104-051, -052, -055, -056, -057, -058, -060, -063

NO. 00757-A

STARTING POINT: INTERSECTION OF NORTH R.O.W. OF LORAIN ST. AND EAST R.O.W. OF HOLLYWOOD ST.

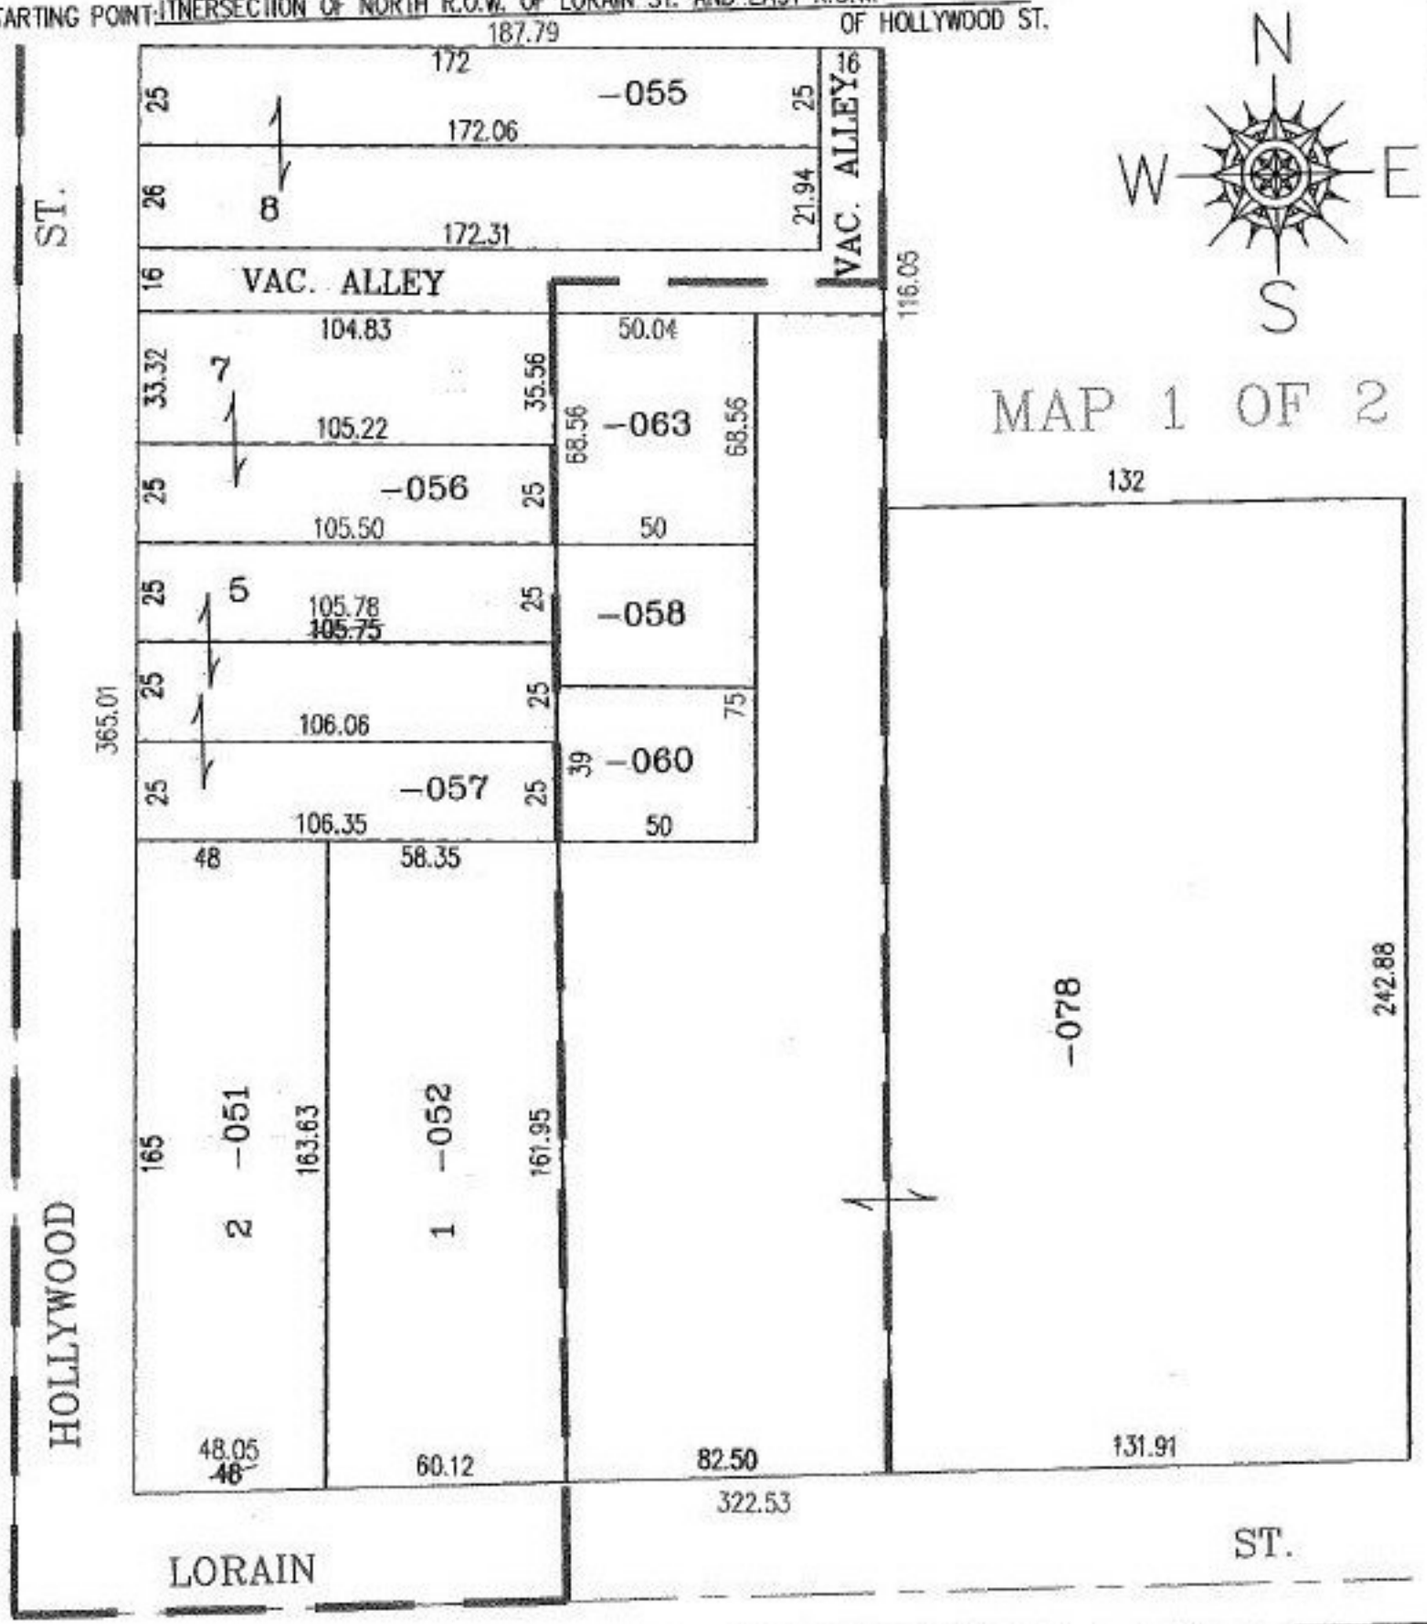

SPLITS/DEEDS PROCESSED

LORAIN COUNTY TAX MAP DEPARTMENT
226 MIDDLE AVE. ELYRIA, OHIO

SURVEYED BY: MICHAEL BRAMHALL
CLOSURE: .02:10.000
MAP PAGE(S): 9-00-075-A
APPROVED BY: RRM DATE: 10-7-02
SCALE: 1"= 50' PRIOR INSTRUMENT: 200066842O