RASTER

PARENT PARCEL: 14-00-068-000-011
CHILD PARCEL: 14-00-068-000-012, -013
STARTING POINT: CENTERLINE OF WAKEMAN-LAGRANGE RD. & PITTS RD.

NO. 00997

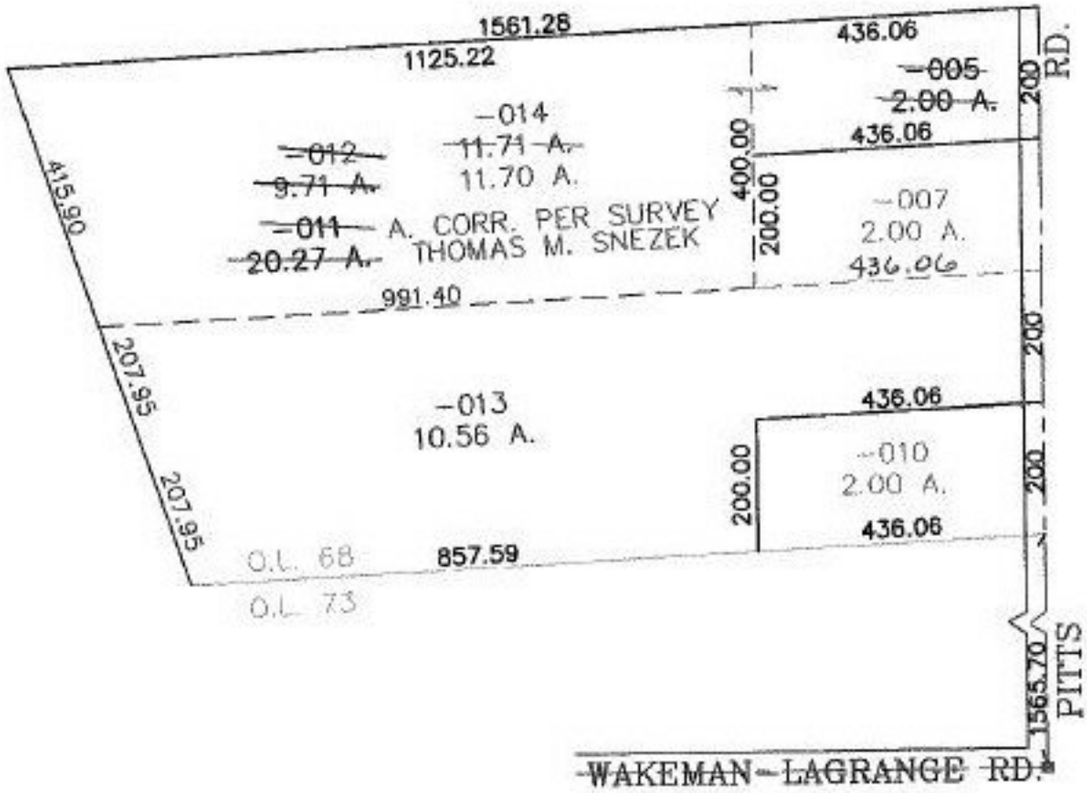

SPLITS/DEEDS PROCESSED
LORAIN COUNTY TAX MAP DEPARTMENT
226 MIDDLE AVE. ELYRIA, OHIO

SURVEYED BY: THOMAS M. SNEZEK
CLOSURE: 0.00 : 10,000
MAP PAGE(S): 14-B
APPROVED BY: JAH DATE: 3-1-02
SCALE: 1"= 300 PRIOR INSTRUMENT: OR 103/557