RASTER

PARENT PARCEL: 14-00-136-000-001, 14-00-137-000-001
CHILD PARCEL: 14-00-136-000-006, -007 14-00-137-000-005, -006
STARTING POINT: CENTERLINE OF ASHLAND-OBERLIN RD. & O.L. 135

NO. 01012

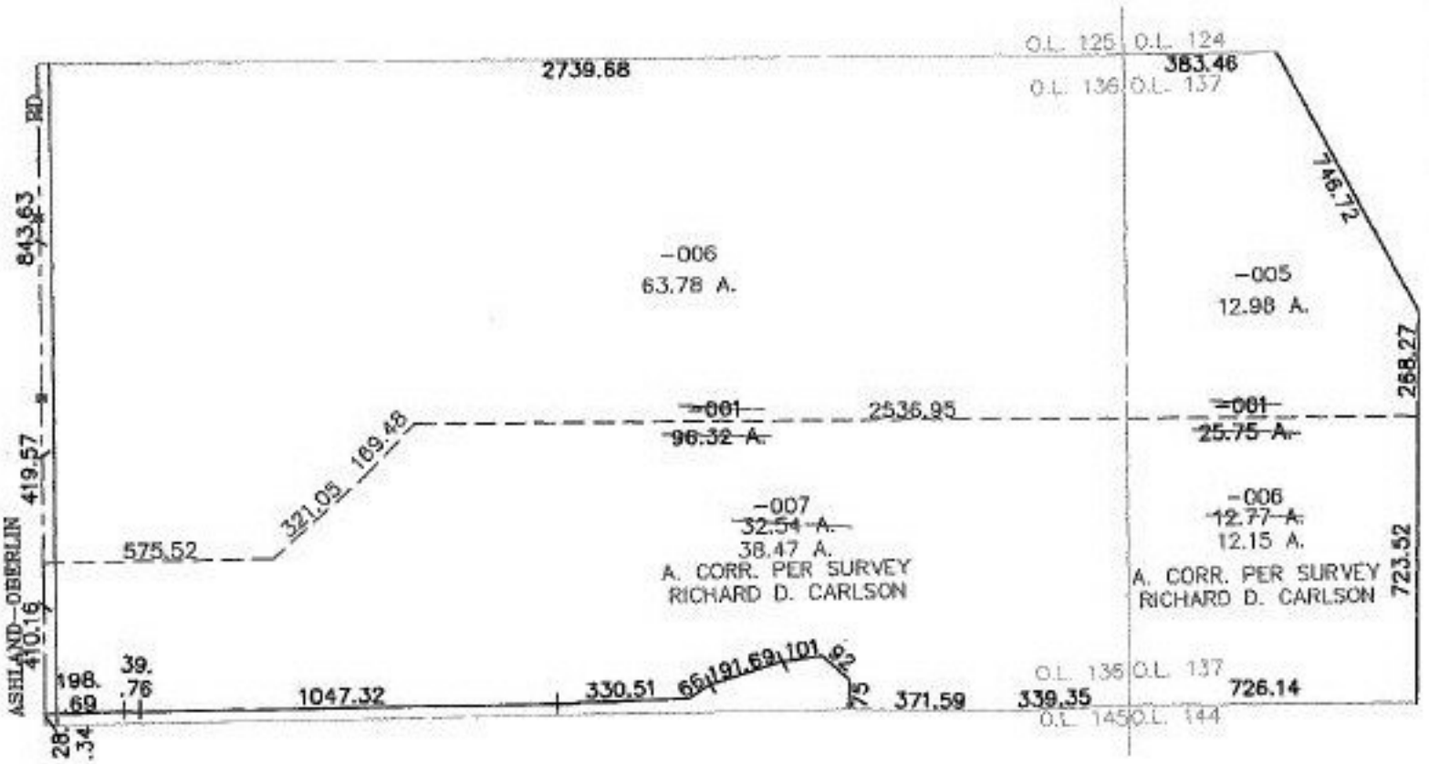

SPLITS/DEEDS PROCESSED

LORAIN COUNTY TAX MAP DEPARTMENT
226 MIDDLE AVE. ELYRIA, OHIO

SURVEYED BY: RICHARD D. CARLSON
CLOSURE: 0.01 : 10,000
MAP PAGE(S): 14-G
APPROVED BY: JAH DATE: 3-18-02
SCALE: 1" = 500 PRIOR INSTRUMENT: 990624752