RASTER

PARENT PARCEL: 19-05-038-000-008, -007
CHILD PARCEL: 19-05-038-000-029 THRU -033
STARTING POINT: CENTERLINE OF FOSTER RD. & O.L. 38

NO. 01013

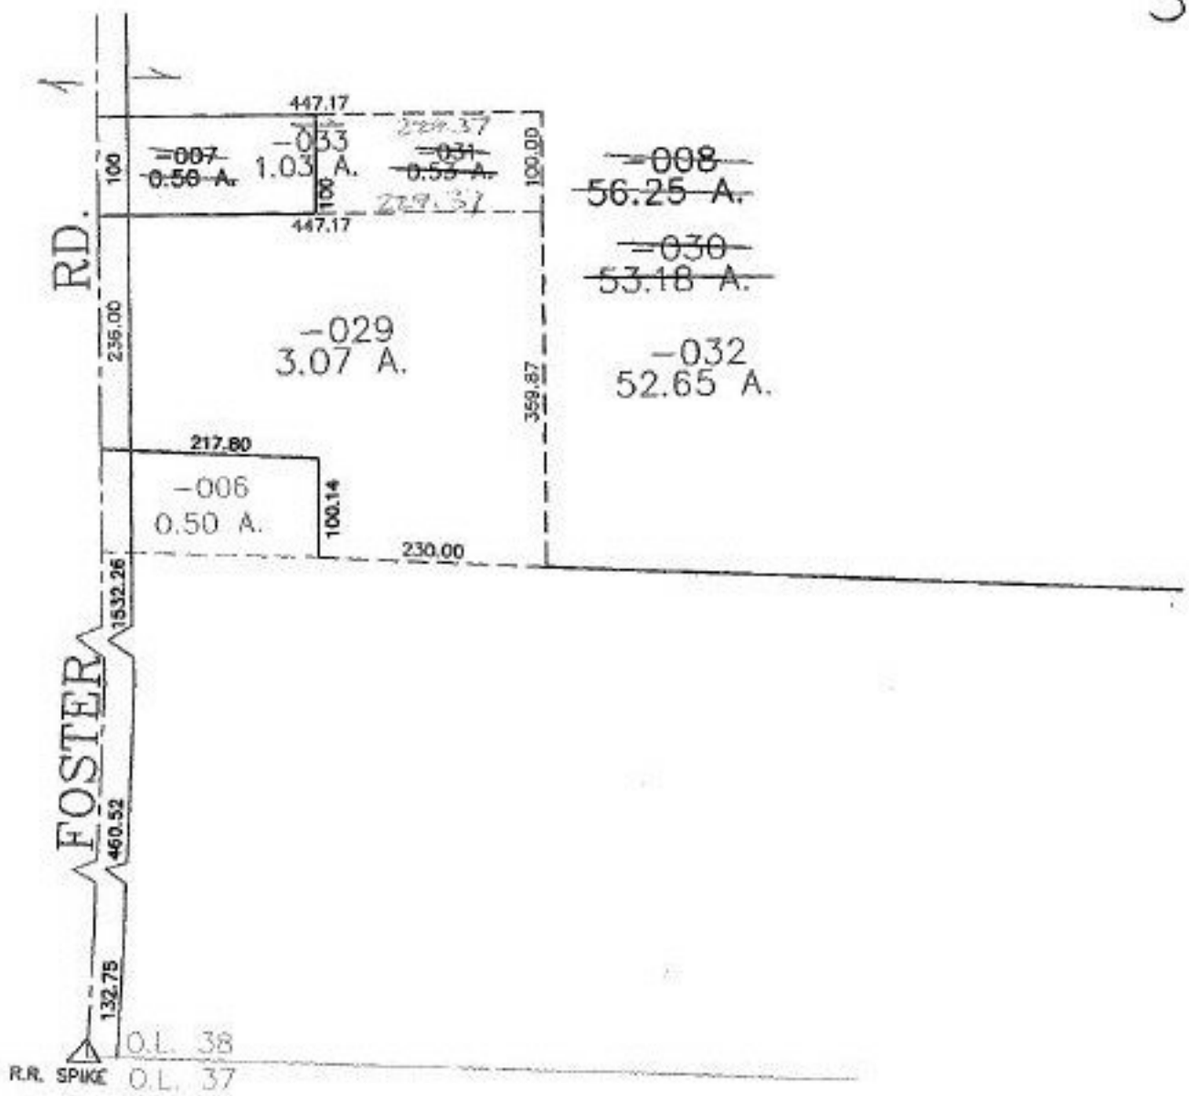

SPLITS/DEEDS PROCESSED
LORAIN COUNTY TAX MAP DEPARTMENT
226 MIDDLE AVE. ELYRIA, OHIO

SURVEYED BY: THOMAS A. SIMON
CLOSURE: 0.00 : 10,000
MAP PAGE(S): 19-C
APPROVED BY: JAH DATE: 3-19-02
SCALE: 1"= 200 PRIOR INSTRUMENT: DV 1248/17