RASTER

PARENT PARCEL: 13-09-009-000-009
CHILD PARCEL: 13-09-009-000-016, -017
STARTING POINT: CENTERLINE OF WAKEMAN-LAGRANGE-RICHFIELD RD. & ROWELL RD.

NO. 01041

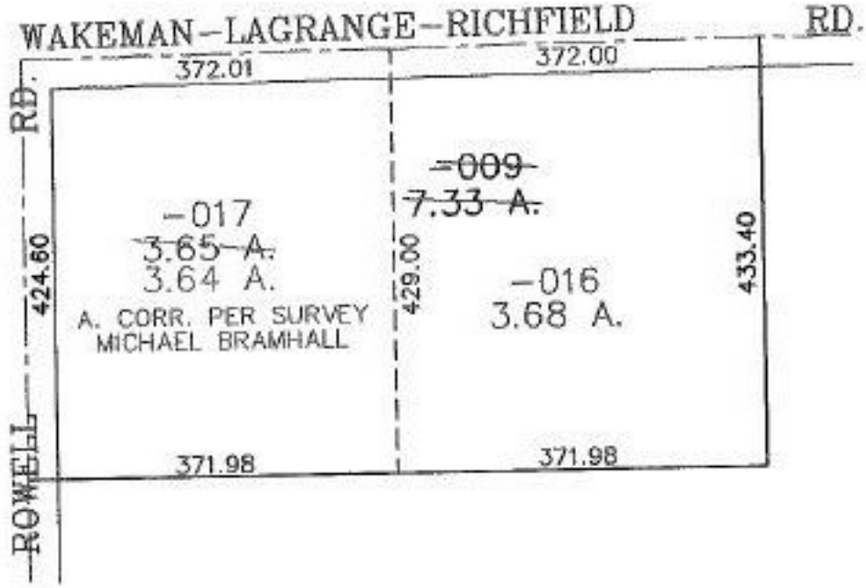

SPLITS/DEEDS PROCESSED
LORAIN COUNTY TAX MAP DEPARTMENT
226 MIDDLE AVE. ELYRIA, OHIO

SURVEYED BY: MICHAEL BRAMHALL
CLOSURE: 0.00 : 10,000
MAP PAGE(S): 13-H
APPROVED BY: JAH DATE: 4-10-02
SCALE: 1"= 200 PRIOR INSTRUMENT: 20010755103