RASTER

PARENT PARCEL: 15-00-031-000-003
CHILD PARCEL: 15-00-031-000-056, -057
STARTING POINT: CENTERLINE OF INDIAN HOLLOW RD. & BIGGS RD.

NO. 01044

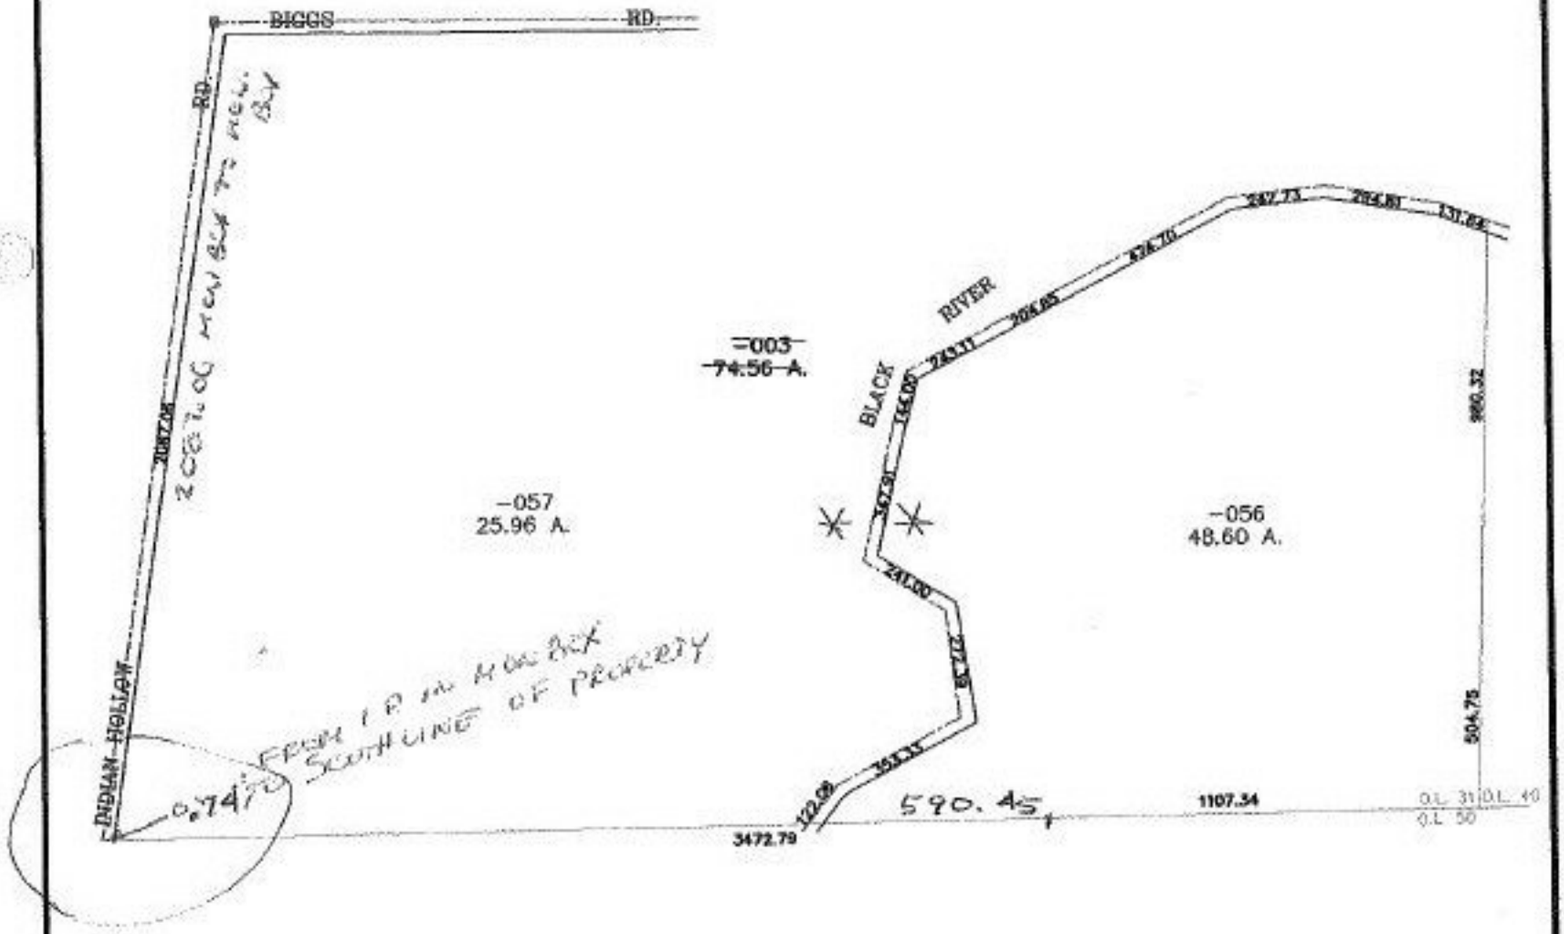

SPLITS/DEEDS PROCESSED

LORAIN COUNTY TAX MAP DEPARTMENT
226 MIDDLE AVE. ELYRIA, OHIO

SURVEYED BY: CHARLES FLANIGAN JR.
CLOSURE: 0.00 : 10,000
MAP PAGE(S): 15-D, 15-00-031-A
APPROVED BY: JAH DATE: 4-12-02
SCALE: 1" = 500 PRIOR INSTRUMENT: 19980564999