PARENT PARCEL: 03-00-011-101-011, 03-00-073-000-064

CHILD PARCEL: 03-00-073-000-065, -066 & 03-00-011-101-012, -013

STARTING POINT: CENTERLINE OF NORTH RIDGE RD. & O.L. 73

NO. 01057

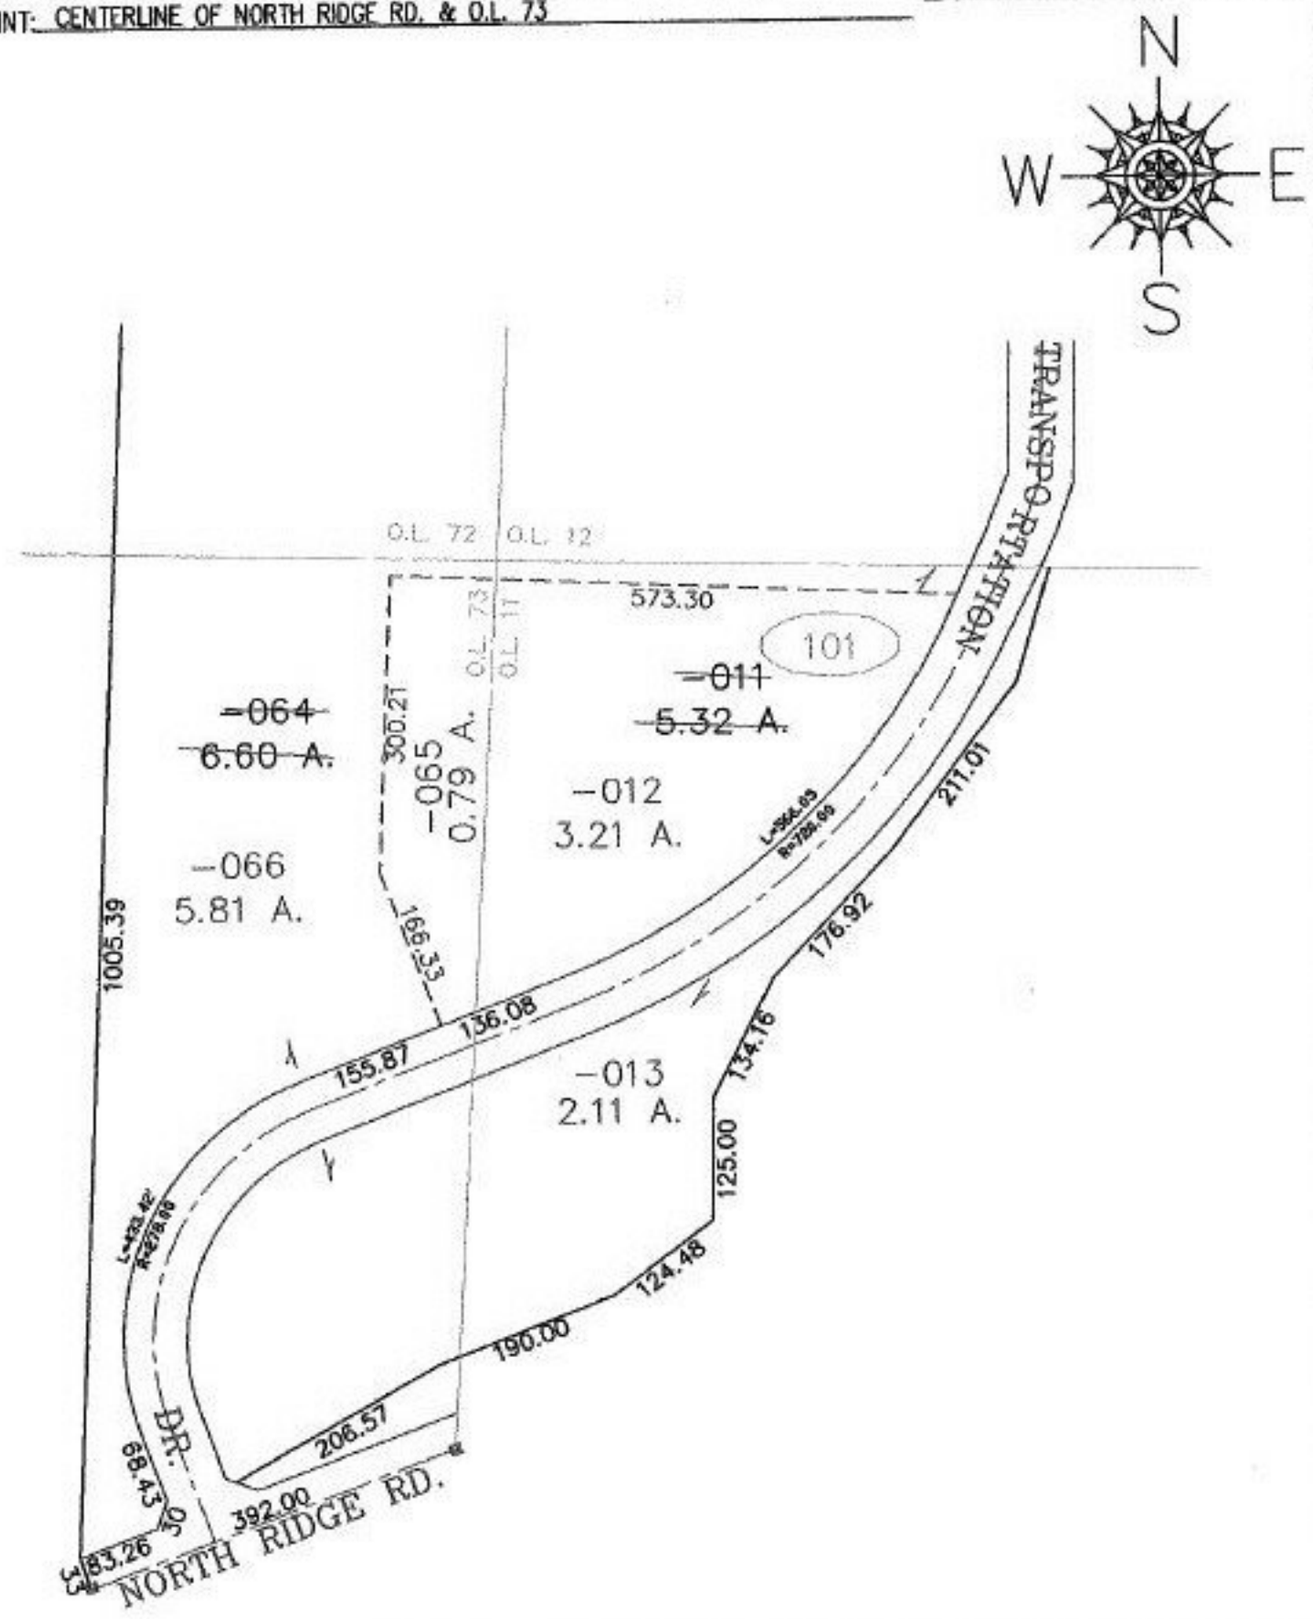

SPLITS/DEEDS PROCESSED

LORAIN COUNTY TAX MAP DEPARTMENT
226 MIDDLE AVE. ELYRIA, OHIO

SURVEYED BY: MICHAEL BRAMHALL

CLOSURE: 0.00 : 10,000

MAP PAGE(S): 3-00-011-A, -073-B

APPROVED BY: JAH DATE: 4-22-02

SCALE: 1" = 200 PRIOR INSTRUMENT: PLAT VOL 71/51