RASTER

PARENT PARCEL: 05-00-011-105-001, -032
CHILD PARCEL: 05-00-011-105-064 THRU -066
STARTING POINT: SOUTHWEST CORNER OF KENDEIGH ALLOT. S/L NO 1

NO. 01095

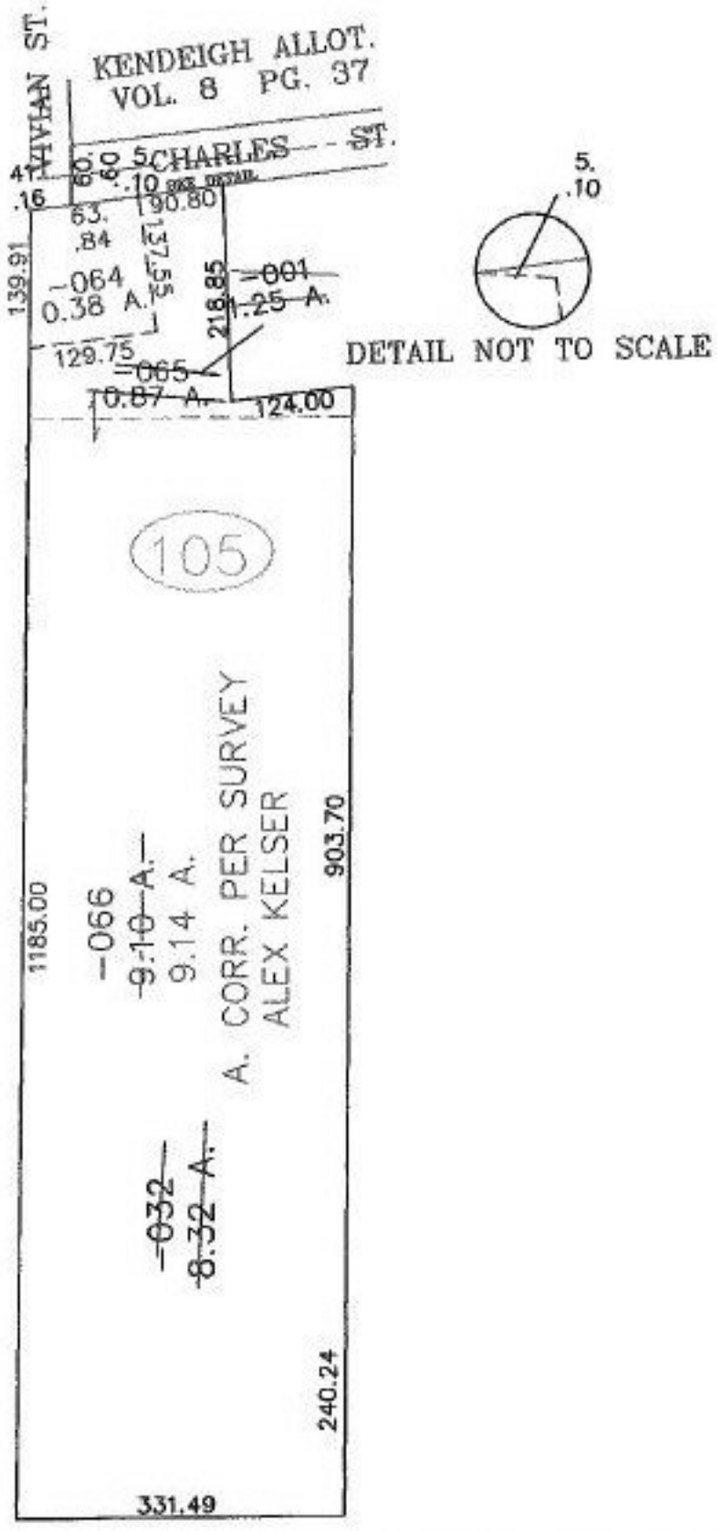

SPLITS/DEEDS PROCESSED
LORAIN COUNTY TAX MAP DEPARTMENT
226 MIDDLE AVE. ELYRIA, OHIO

SURVEYED BY: ALEX KELSER
CLOSURE: 0.00 : 10,000
MAP PAGE(S): 5-00-011-B
APPROVED BY: JAH DATE: 5-29-02
SCALE: 1"= 200 PRIOR INSTRUMENT: 20020824193