RASTER

PARENT PARCEL: *SEE BELOW

CHILD PARCEL: 06-24-095-000-016

STARTING POINT: SIDELINE OF CONRAIL RAILROAD & O.L. 96

NO. 01104

*06-24-094-000-001
06-24-094-000-002
06-24-095-000-007
06-24-095-000-008
06-24-095-000-012
06-24-095-000-015
06-24-096-000-004
06-24-096-000-011
06-24-096-000-013

N
W E
S

TAX MAP TO COMBINE OVER ORIGINAL
LOT LINES PER MARK STEWART 6-11-02

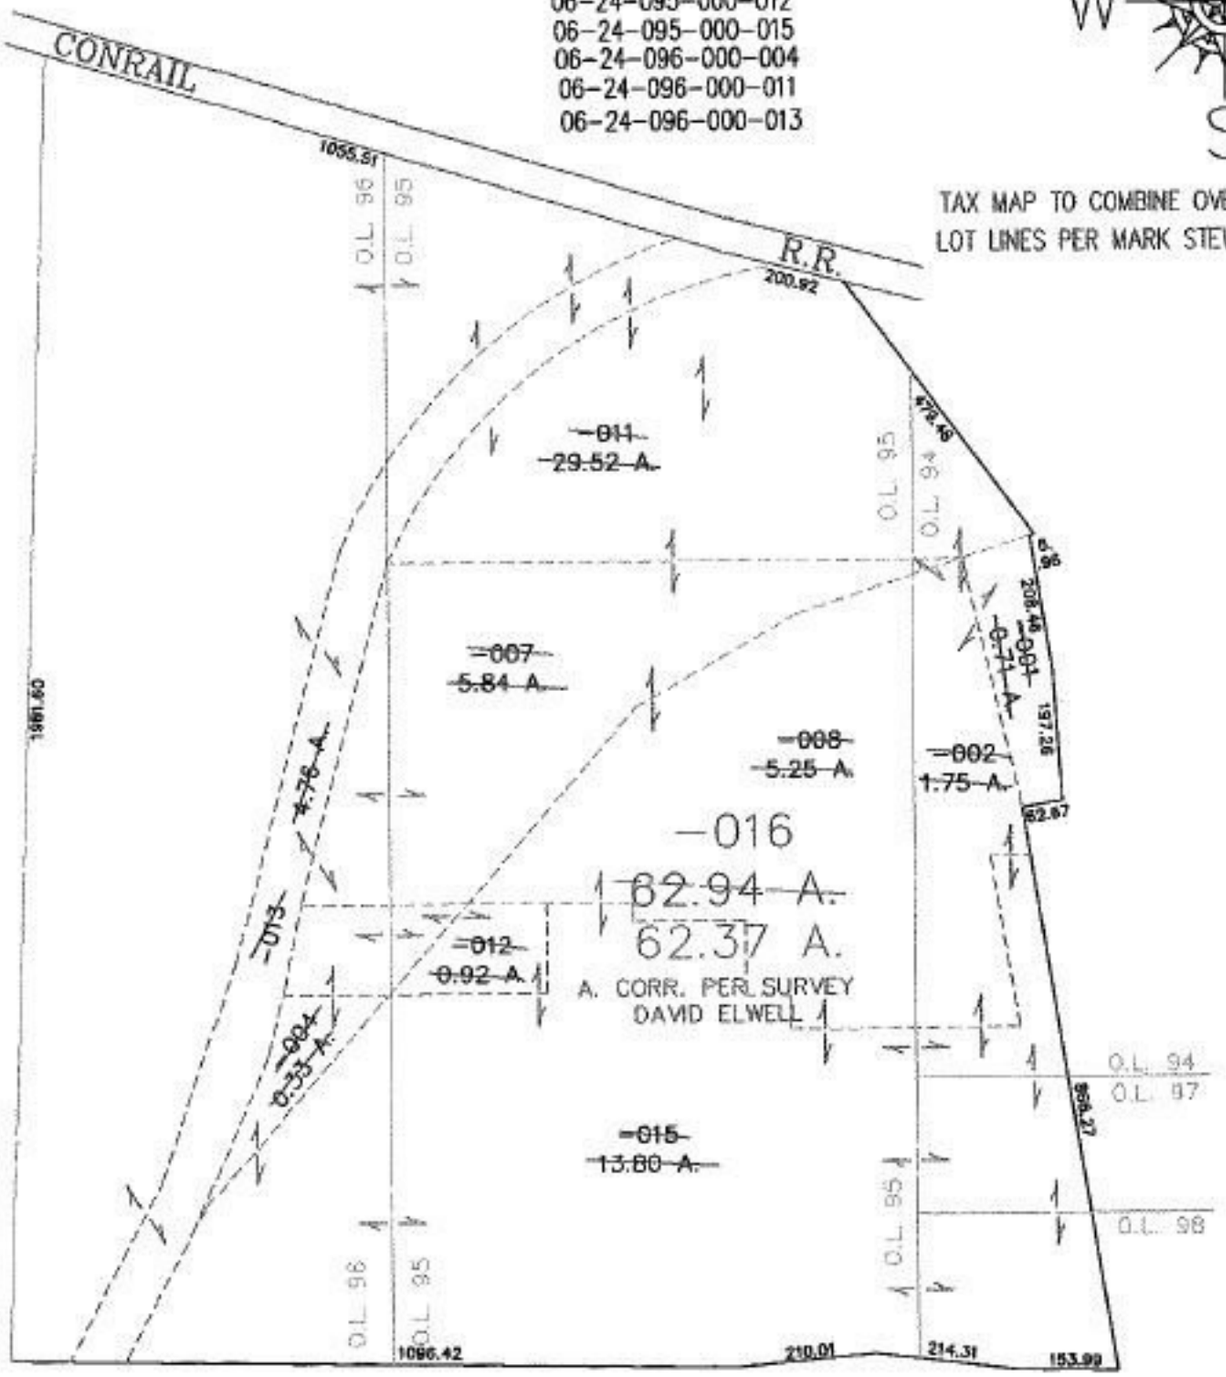

SPLITS/DEEDS PROCESSED

LORAIN COUNTY TAX MAP DEPARTMENT
226 MIDDLE AVE. ELYRIA, OHIO

SURVEYED BY: DAVID L. ELWELL
CLOSURE: 0.00 : 10,000
MAP PAGE(S): 6-98, 6-116
APPROVED BY: JAH DATE: 6-10-02
SCALE: 1"= 300 PRIOR INSTRUMENT: OR 495/819