RASTER

PARENT PARCEL: 18-00-008-000-033
CHILD PARCEL: 18-00-008-000-037 THRU -039
STARTING POINT: CENTERLINE OF PECK-WADSWORTH RD. & HAWLEY RD.

NO. 01105

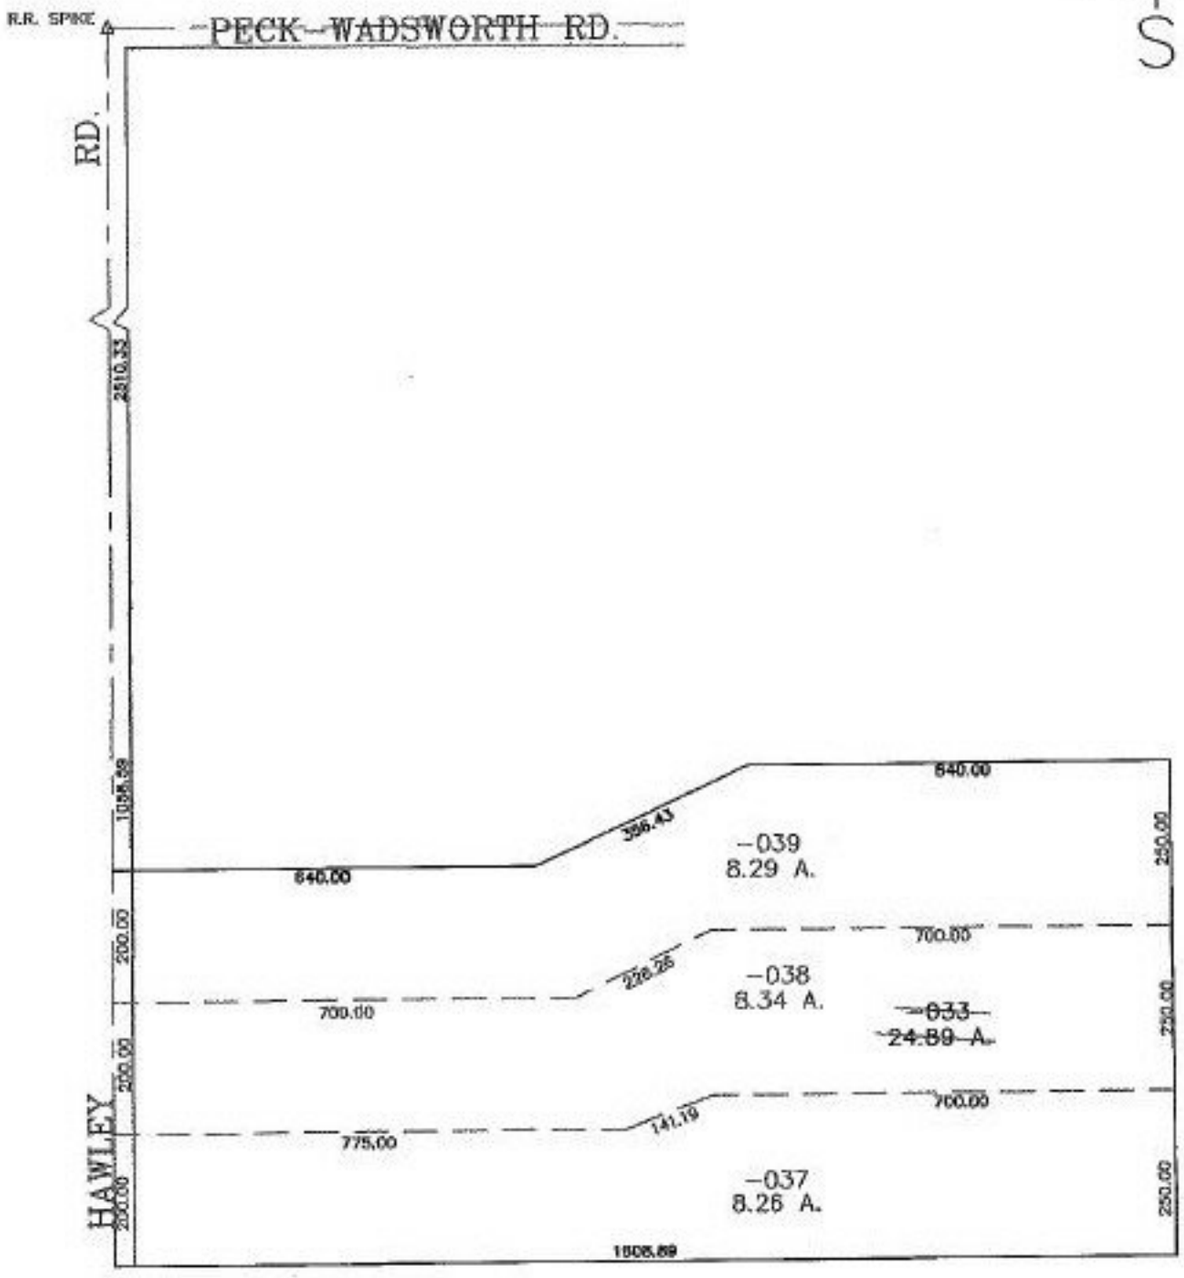

SPLITS/DEEDS PROCESSED
LORAIN COUNTY TAX MAP DEPARTMENT
226 MIDDLE AVE. ELYRIA, OHIO

SURVEYED BY: ROBERT A. DAMON
CLOSURE: 0.00 : 10,000
MAP PAGE(S): 18-00-009-A
APPROVED BY: JAH DATE: 6-11-02
SCALE: 1"= 300 PRIOR INSTRUMENT: 200283198