RASTER

PARENT PARCEL: 02-03-001-108-002, -003
CHILD PARCEL: 02-03-001-108-035 THRU -038
STARTING POINT: CENTERLINE IF FULMER RD. & MEISTER RD.

NO. 01112

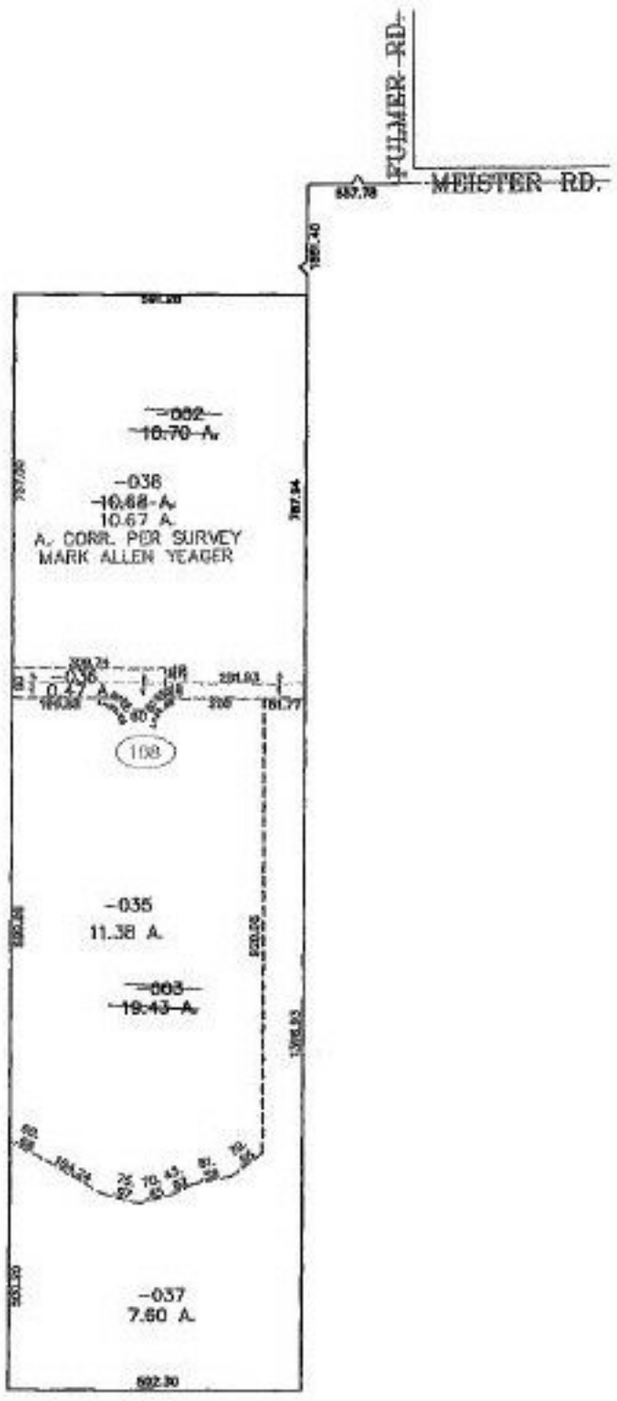

SPLITS/DEEDS PROCESSED
LORAIN COUNTY TAX MAP DEPARTMENT
226 MIDDLE AVE. ELYRIA, OHIO

SURVEYED BY: MARK ALLEN YEAGER
CLOSURE: 0.00 : 10,000
MAP PAGE(S): 02-03-001-D
APPROVED BY: JAH DATE: 6-17-02
SCALE: 1"= 400 PRIOR INSTRUMENT: 20010732206