RASTER

PARENT PARCEL: 15-00-015-000-004
CHILD PARCEL: 15-00-015-000-011, -012
STARTING POINT: CENTERLINE OF LAGRANGE RD. & O.L. 15

NO. 01130

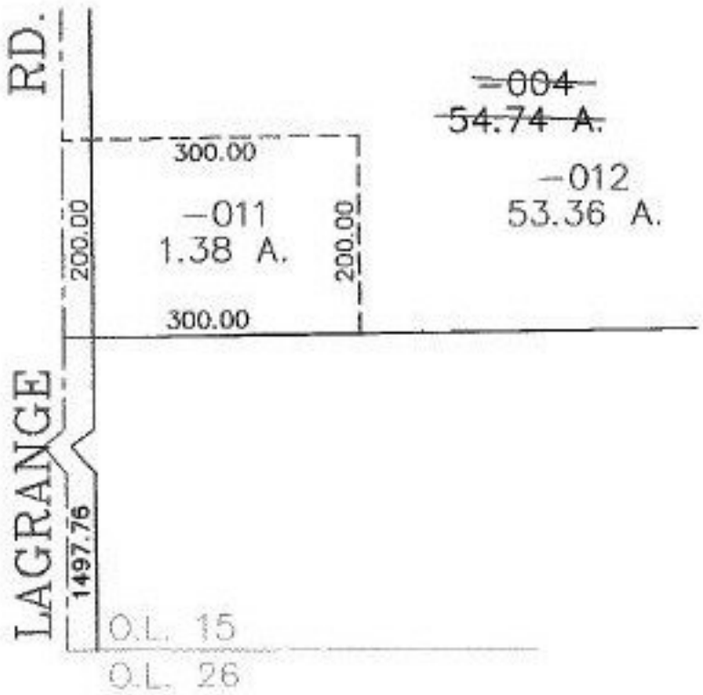

SPLITS/DEEDS PROCESSED
LORAIN COUNTY TAX MAP DEPARTMENT
226 MIDDLE AVE. ELYRIA, OHIO

SURVEYED BY: RICHARD D. CARLSON
CLOSURE: 0.00 : 10,000
MAP PAGE(S): 15-00-015-C
APPROVED BY: JAH DATE: 7-1-02
SCALE: 1"= 200 PRIOR INSTRUMENT: 20020806694