RASTER

PARENT PARCEL: 06-23-013-105-067
CHILD PARCEL: 06-23-013-105-074 THRU -076
STARTING POINT: CENTERLINE OF SCHADEN RD. & MEADOWFIELD CT.

NO. 01132

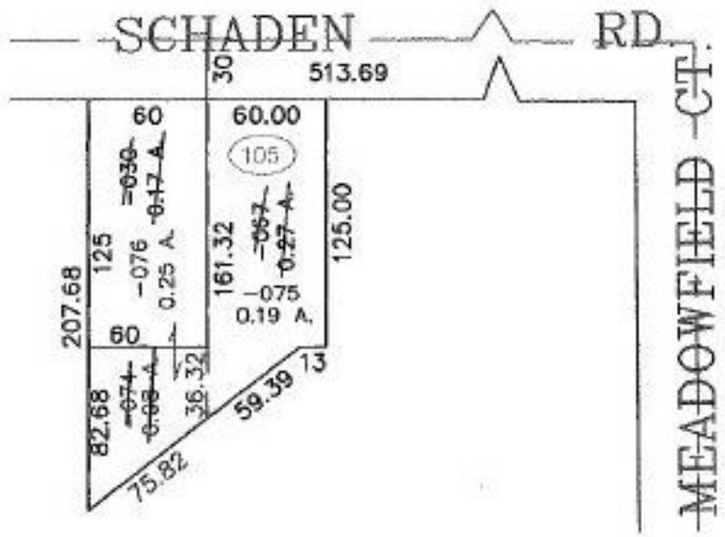

SPLITS/DEEDS PROCESSED

LORAIN COUNTY TAX MAP DEPARTMENT
226 MIDDLE AVE. ELYRIA, OHIO

SURVEYED BY: DAVID L. ELWELL
CLOSURE: 0.00 : 10,000
MAP PAGE(S): 6-28
APPROVED BY: JAH DATE: 7-1-02
SCALE: 1"= 100 PRIOR INSTRUMENT: 20020834840