RASTER

PARENT PARCEL: 10-00-024-000-095
CHILD PARCEL: 10-00-024-000-167 THRU -169
STARTING POINT: CENTERLINE OF BANKS RD. & O.L. 24

NO. 01145

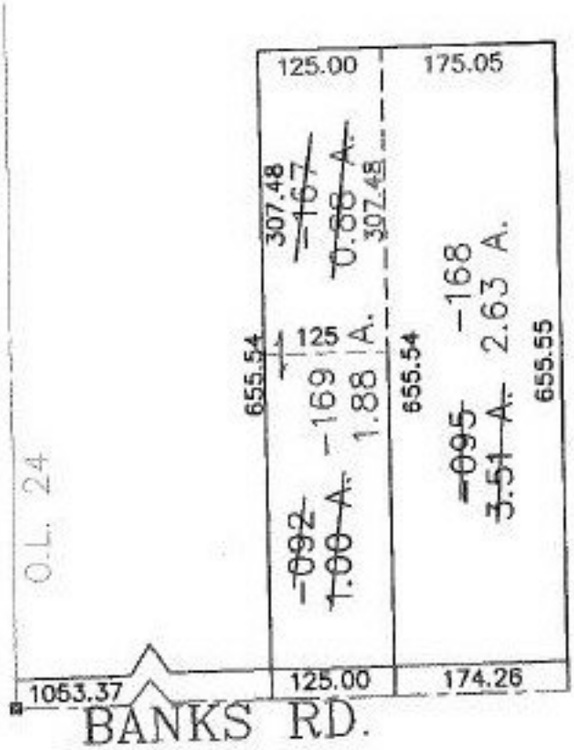

SPLITS/DEEDS PROCESSED
LORAIN COUNTY TAX MAP DEPARTMENT
226 MIDDLE AVE. ELYRIA, OHIO

SURVEYED BY: ALEX KELSER
CLOSURE: 0.00 : 10,000
MAP PAGE(S): 10-00-024-A
APPROVED BY: JAH DATE: 7-18-02
SCALE: 1"= 200 PRIOR INSTRUMENT: DV 982/955