RASTER

PARENT PARCEL: 03-00-053-106-013
CHILD PARCEL: 03-00-053-900-003, 03-00-053-106-023
STARTING POINT: CENTERLINE OF COLORADO AVE. & O.L. 53

NO. 01147

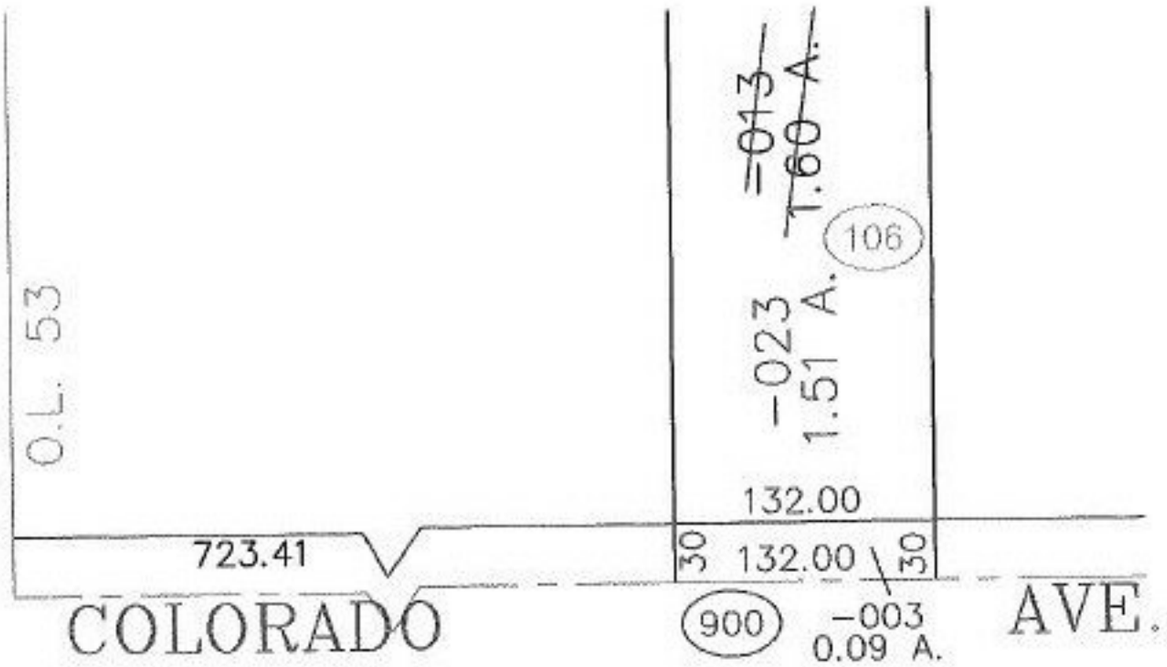

SPLITS/DEEDS PROCESSED

LORAIN COUNTY TAX MAP DEPARTMENT
226 MIDDLE AVE. ELYRIA, OHIO

SURVEYED BY: BRAIN P. MCCARTNEY
CLOSURE: 0.00 : 10.000
MAP PAGE(S): 03-00-053-A
APPROVED BY: JAH DATE: 7-17-02
SCALE: 1"= 100 PRIOR INSTRUMENT: OR 1018/360