RASTER

PARENT PARCEL: 03-00-055-121-007, -008
CHILD PARCEL: 03-00-055-900-001, 03-00-055-121-020
STARTING POINT: CENTERLINE OF COLORADO AVE. & O.L. 55

NO. 01148

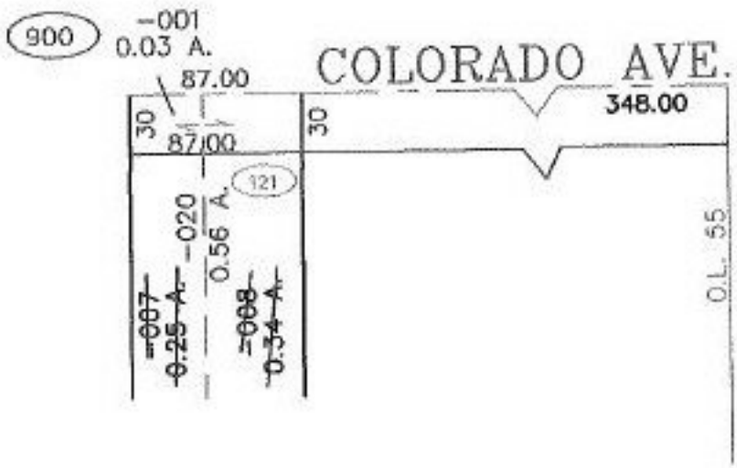

SPLITS/DEEDS PROCESSED

LORAIN COUNTY TAX MAP DEPARTMENT
226 MIDDLE AVE. ELYRIA, OHIO

SURVEYED BY: BRIAN P. MCCARTNEY
CLOSURE: 0.00 : 10,000
MAP PAGE(S): 03-00-055-A
APPROVED BY: JAH DATE: 7-17-02
SCALE: 1"= 100 PRIOR INSTRUMENT: 19990637363