RASTER

PARENT PARCEL: 03-00-063-000-046, -069
CHILD PARCEL: 03-00-063-000-070 THRU -073
STARTING POINT: NORTHEAST CORNER OF MARCUS DR.

NO. 01154

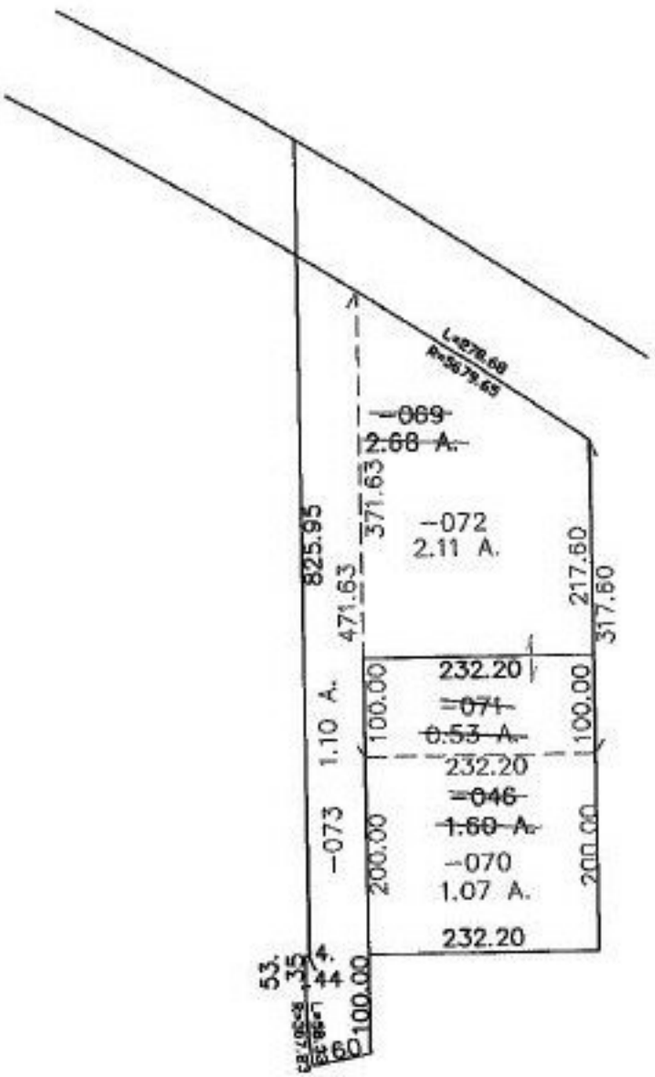

SPLITS/DEEDS PROCESSED
LORAIN COUNTY TAX MAP DEPARTMENT
226 MIDDLE AVE. ELYRIA, OHIO

SURVEYED BY: MICHAEL G HURA
CLOSURE: 0.00 : 10,000
MAP PAGE(S): 03-00-063
APPROVED BY: JAH DATE: 8-1-02
SCALE: 1"= 200 PRIOR INSTRUMENT: OR 2/74