RASTER

PARENT PARCEL: 05-00-072-000-024, -026, -018, -028, -012

CHILD PARCEL: 05-00-072-000-050 THRU -067

STARTING POINT: CORNER POST IN THE INTERSECTION OF O.L. 72 & O.L. 71

NO. 01158

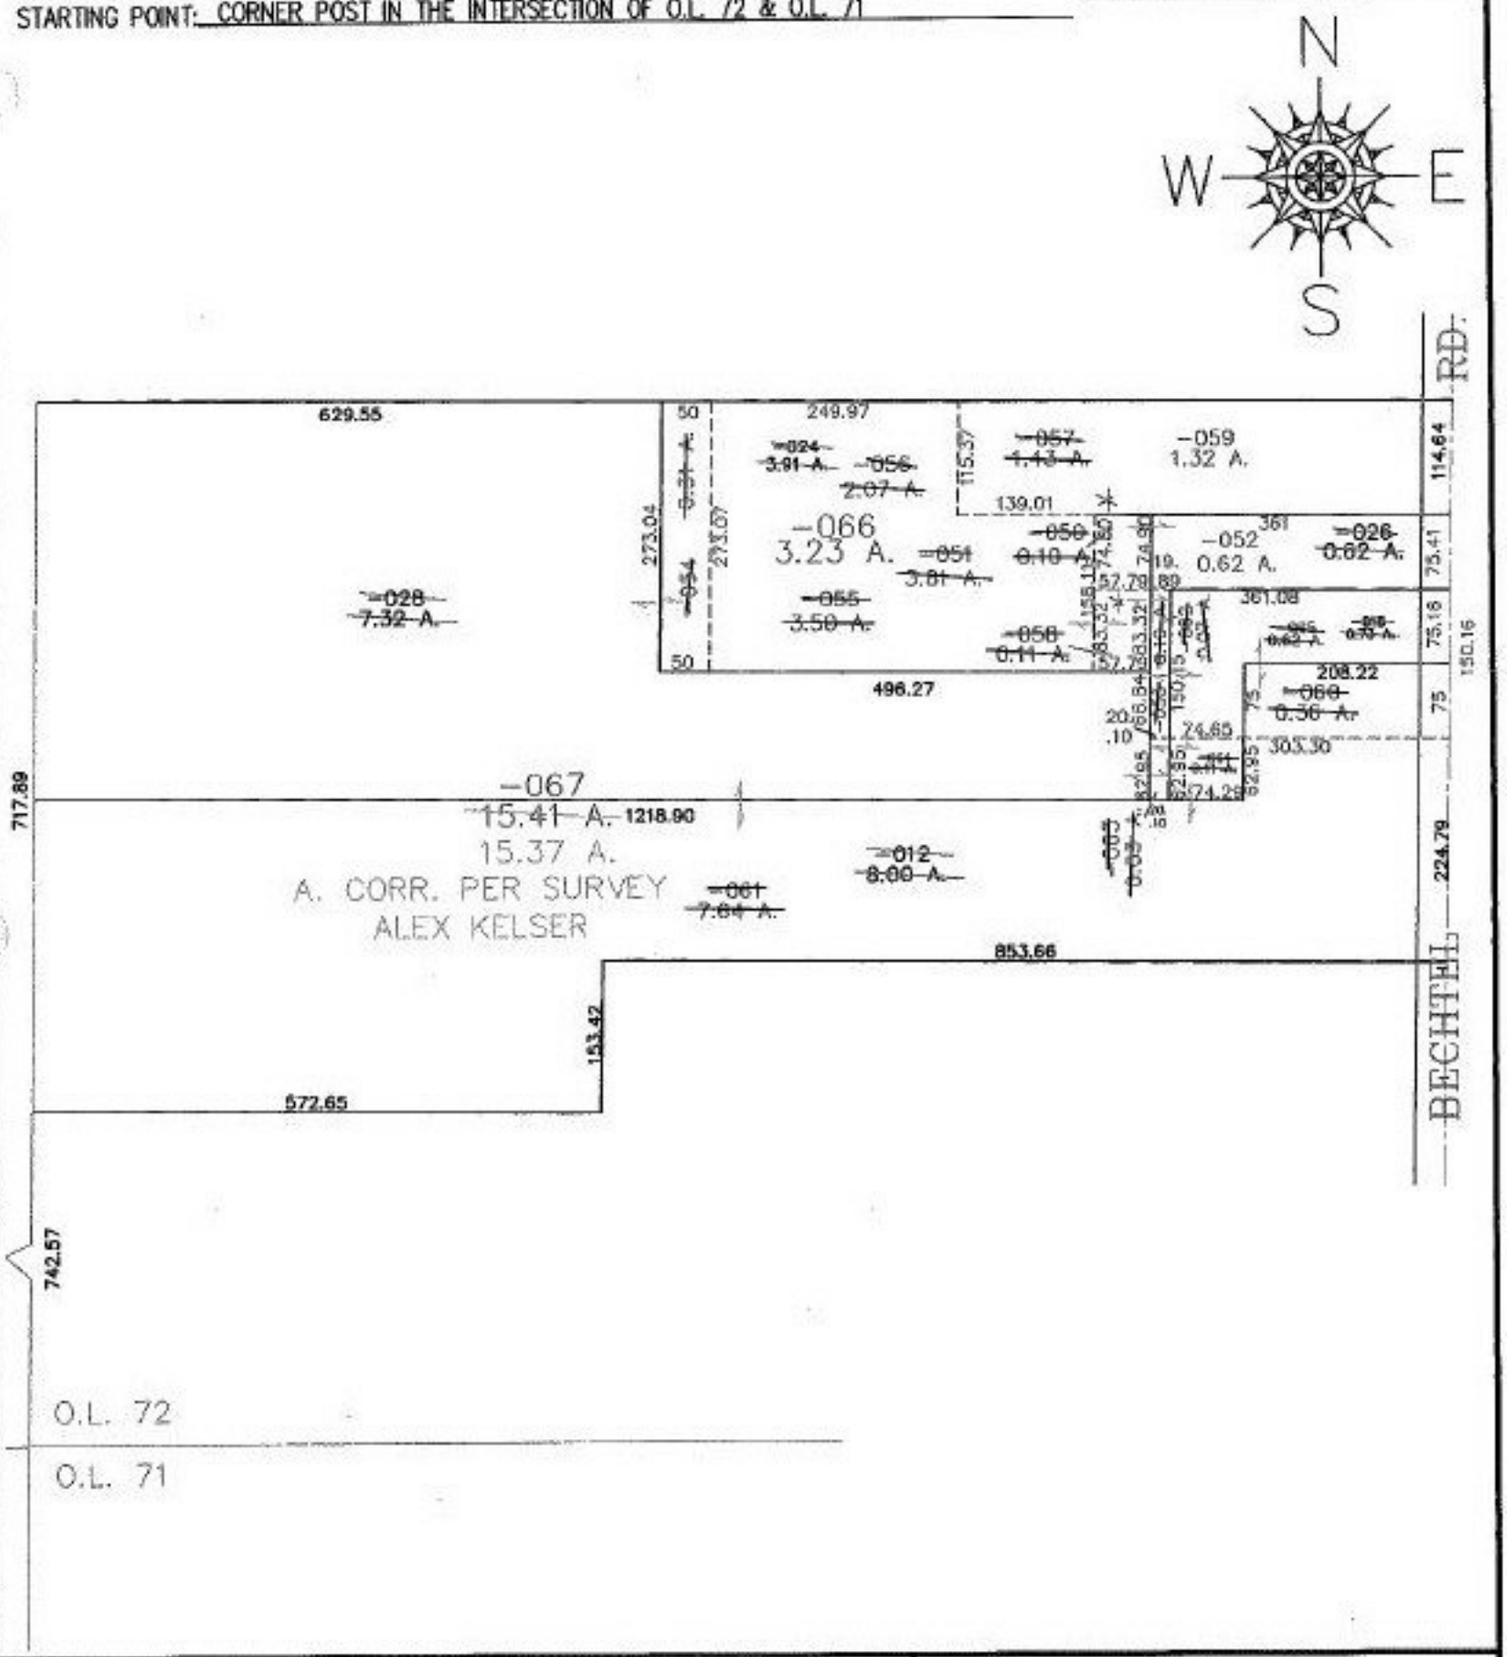

SPLITS/DEEDS PROCESSED

LORAIN COUNTY TAX MAP DEPARTMENT
226 MIDDLE AVE. ELYRIA, OHIO

SURVEYED BY: ALEX KELSER

CLOSURE: 0.00 : 10,000

MAP PAGE(S): 5-H

APPROVED BY: JAH DATE: 7-23-02

SCALE: 1" = 200 PRIOR INSTRUMENT: 20000705832