RASTER

PARENT PARCEL: 13-11-003-000-009
CHILD PARCEL: 13-11-003-000-010 THRU -013
STARTING POINT: CENTERLINE OF BATES RD. & BAIRD RD.

NO. 01165

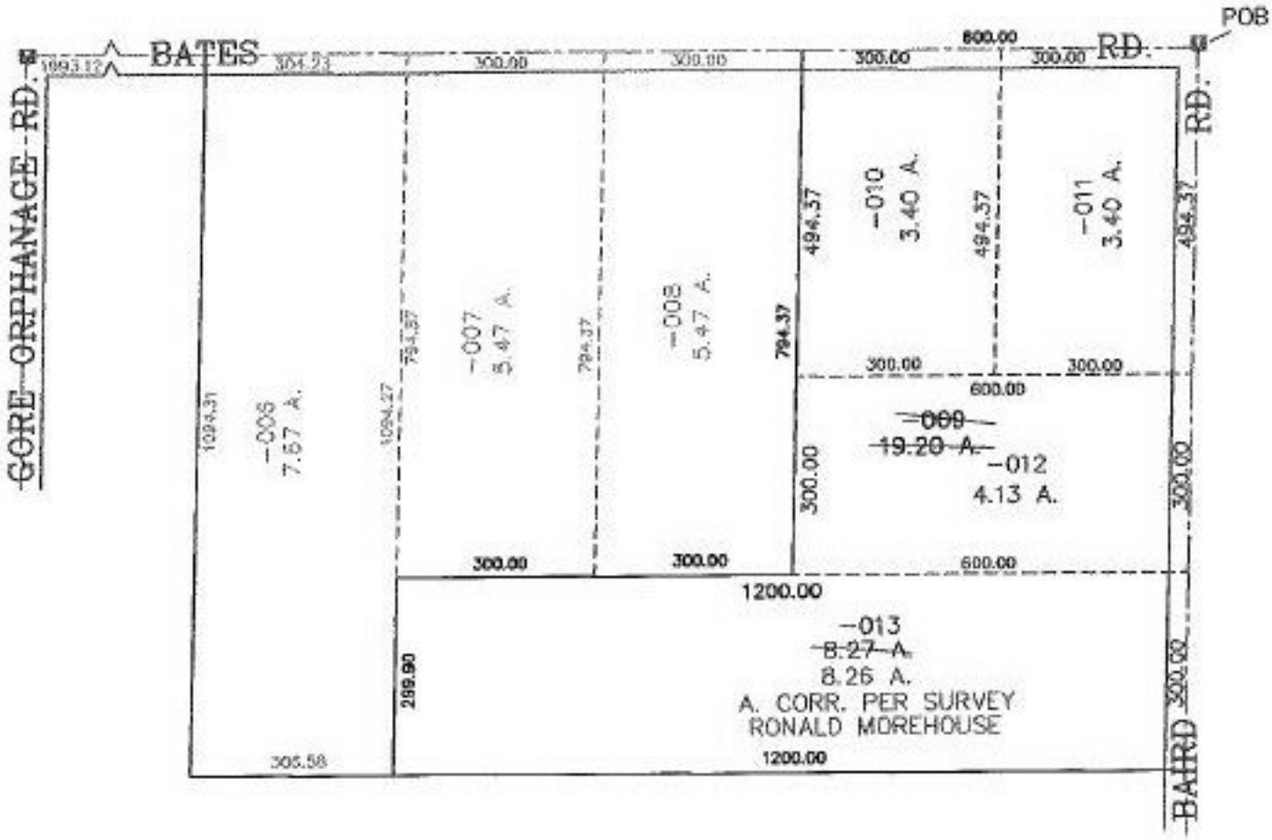


SPLITS/DEEDS PROCESSED
LORAIN COUNTY TAX MAP DEPARTMENT
226 MIDDLE AVE. ELYRIA, OHIO

SURVEYED BY: RONALD A. MOREHOUSE
CLOSURE: 0.00 : 10,000
MAP PAGE(S): 13-B
APPROVED BY: JAH DATE: 7-30-02
SCALE: 1" = 300 PRIOR INSTRUMENT: 20020841621