RASTER

PARENT PARCEL: 11-00-084-000-029, -028, -027
CHILD PARCEL: 11-00-084-000-069 THRU -074
STARTING POINT: CENTERLINE OF DURKEE RD. & CAPEL RD.

NO. 01170

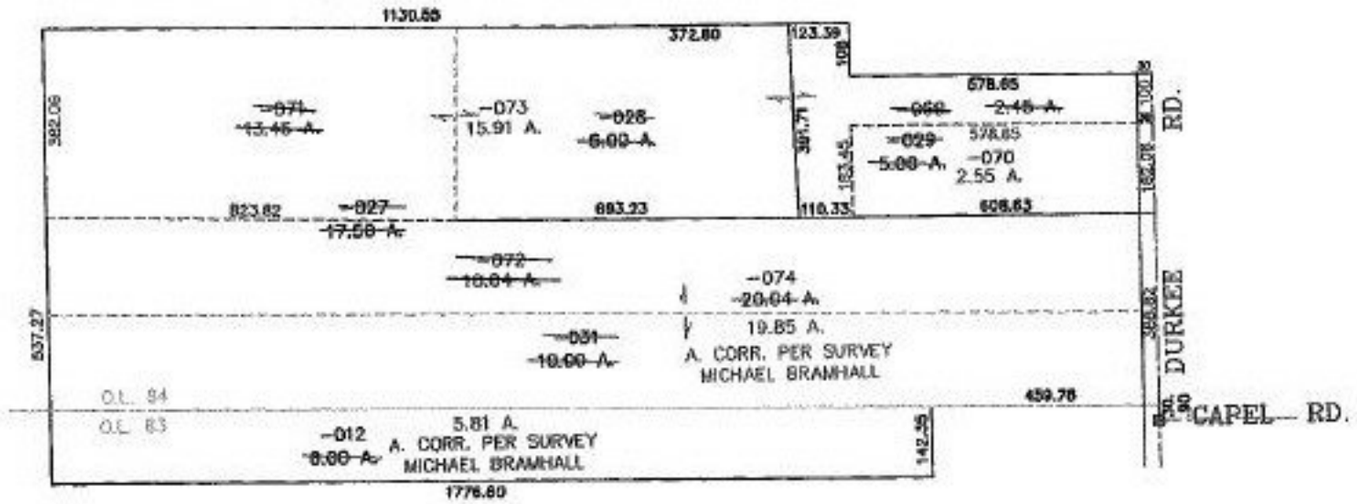

SPLITS/DEEDS PROCESSED
LORAIN COUNTY TAX MAP DEPARTMENT
226 MIDDLE AVE. ELYRIA, OHIO

SURVEYED BY: MICHAEL BRAMHALL
CLOSURE: 0.01 : 10,000
MAP PAGE(S): 11-00-084, 11-F SOUTH
APPROVED BY: JAH DATE: 8-2-02
SCALE: 1" = 400 PRIOR INSTRUMENT: 20020826296