RASTER

PARENT PARCEL: 10-00-004-126-031, 10-00-004-125-043, 050, 051, 053, 054 057 058

CHILD PARCEL: 10-00-004-125-058 THRU -060

STARTING POINT: CENTERLINE OF HOPE COURT & MEDINA-ELYRIA RD.

NO. 01173

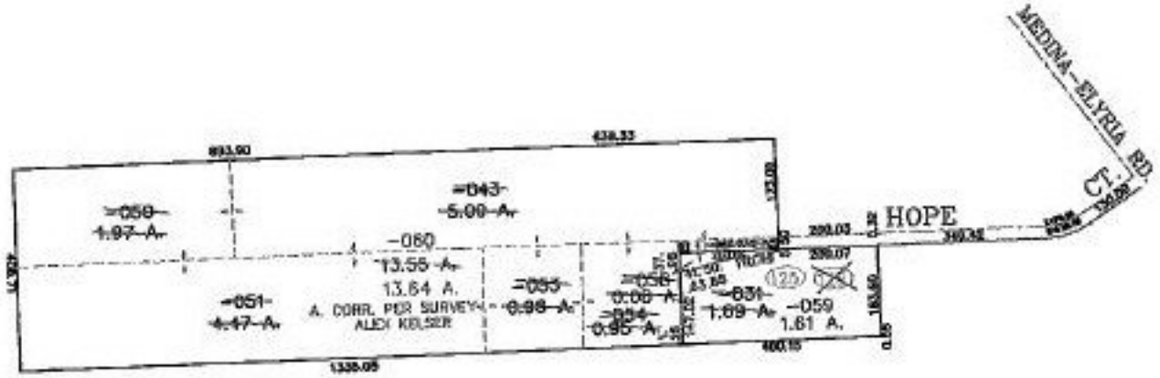


SPLITS/DEEDS PROCESSED

LORAIN COUNTY TAX MAP DEPARTMENT
226 MIDDLE AVE. ELYRIA, OHIO

SURVEYED BY: ALEX KELSER

CLOSURE: 0.00 : 10,000

MAP PAGE(S): 10-00-004-C

APPROVED BY: JAH DATE: 8-8-02

SCALE: 1" = 400 PRIOR INSTRUMENT: DV 826/144