RASTER

PARENT PARCEL: 03-00-113-102-047, -088
CHILD PARCEL: 03-00-113-102-099 THRU -103
STARTING POINT: SIDELINE OF BROADWAY AVE. & S/L 17

NO. 001187

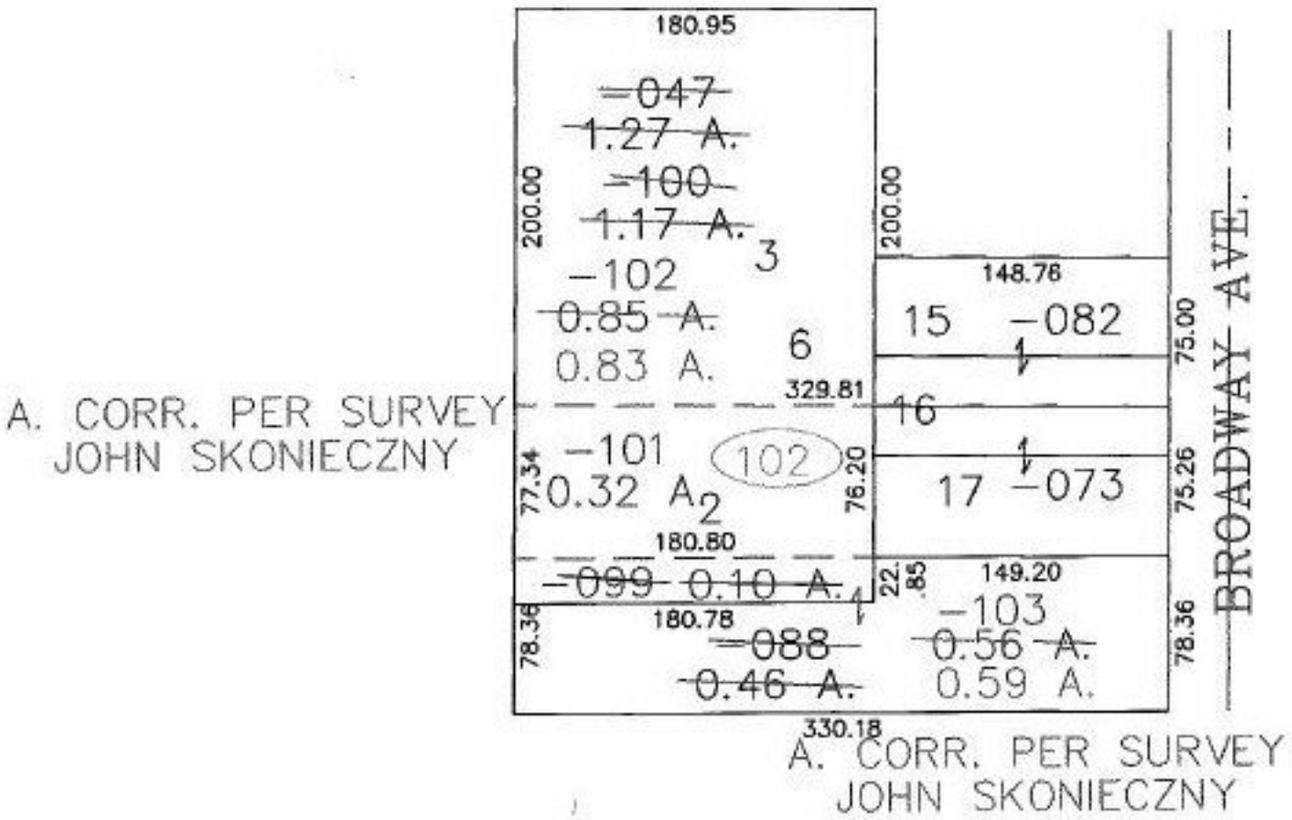

SPLITS/DEEDS PROCESSED

LORAIN COUNTY TAX MAP DEPARTMENT
226 MIDDLE AVE. ELYRIA, OHIO

SURVEYED BY: JOHN C. SKONIECZNY
CLOSURE: 0.00 : 10,000
MAP PAGE(S): 03-00-113-A
APPROVED BY: JAH DATE: 10-19-02
SCALE: 1"= 100 PRIOR INSTRUMENT: DV 476/15