RASTER

PARENT PARCEL: 01-00-030-000-019
CHILD PARCEL: 01-00-030-000-037, -038
STARTING POINT: CENTERLINE OF JERUSALEM RD. & O.L. 30

NO. 01190

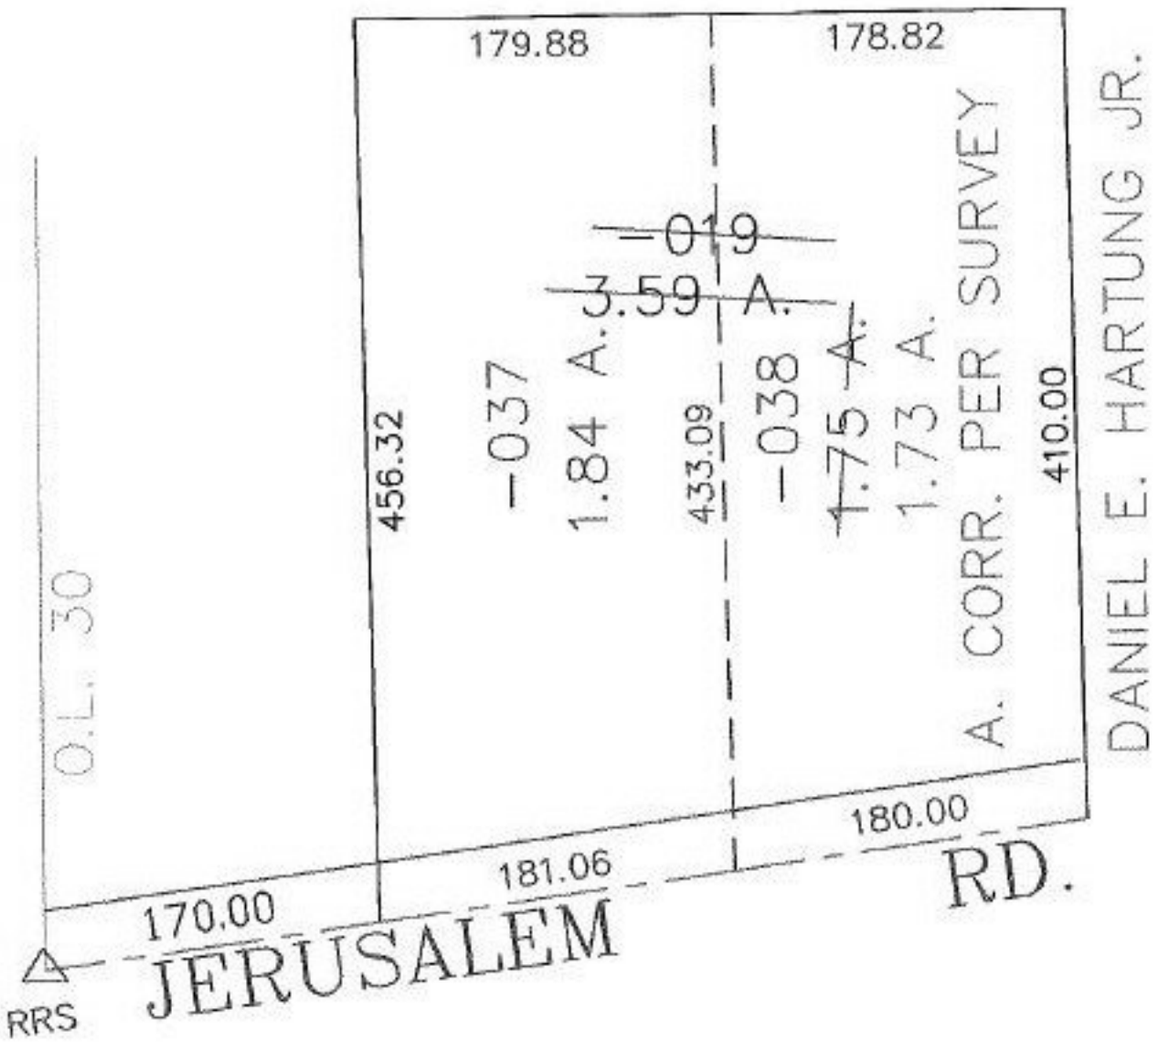

SPLITS/DEEDS PROCESSED

LORAIN COUNTY TAX MAP DEPARTMENT
226 MIDDLE AVE. ELYRIA, OHIO

SURVEYED BY: DANIEL E. HARTUNG JR.
CLOSURE: 0.00 : 10,000
MAP PAGE(S): 01-00-030-A
APPROVED BY: JAH DATE: 9-3-02
SCALE: 1" = 100 PRIOR INSTRUMENT: OR 1181/584