RASTER

PARENT PARCEL: 11-00-051-000-095, -075, -009 11-00-070-000-086
CHILD PARCEL: 11-00-051-000-113 THRU -115 11-00-070-000-126, -127
STARTING POINT: CENTERLINE OF BUTTERNUT RIDGE RD. & ARCHER RD.

NO. 01193

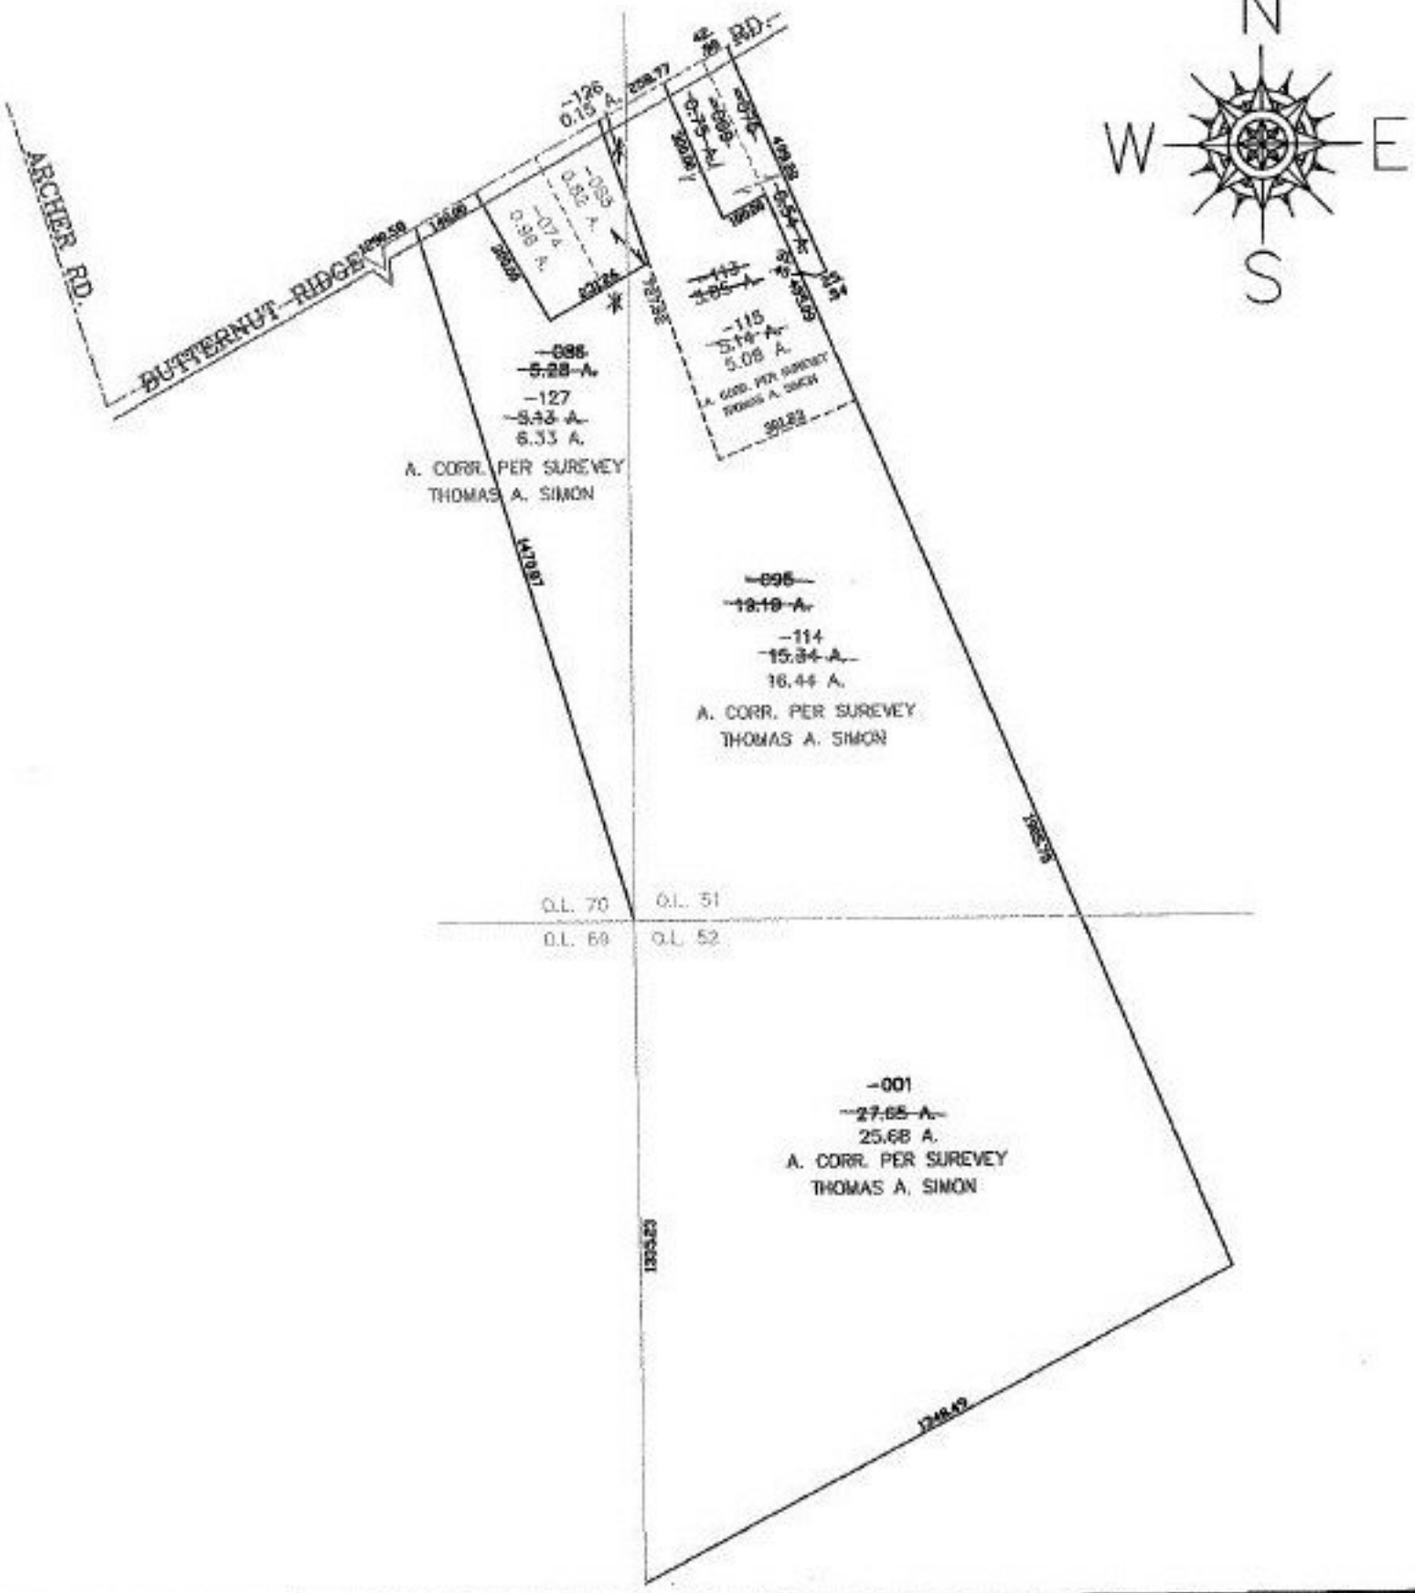

SPLITS/DEEDS PROCESSED
LORAIN COUNTY TAX MAP DEPARTMENT
226 MIDDLE AVE. ELYRIA, OHIO

SURVEYED BY: THOMAS A. SIMON
CLOSURE: 0.01 : 10,000
MAP PAGE(S): 11-00-051-A 11-00-070-B
APPROVED BY: JAH DATE: 9-3-02
SCALE: 1" = 400 PRIOR INSTRUMENT: 20010775777