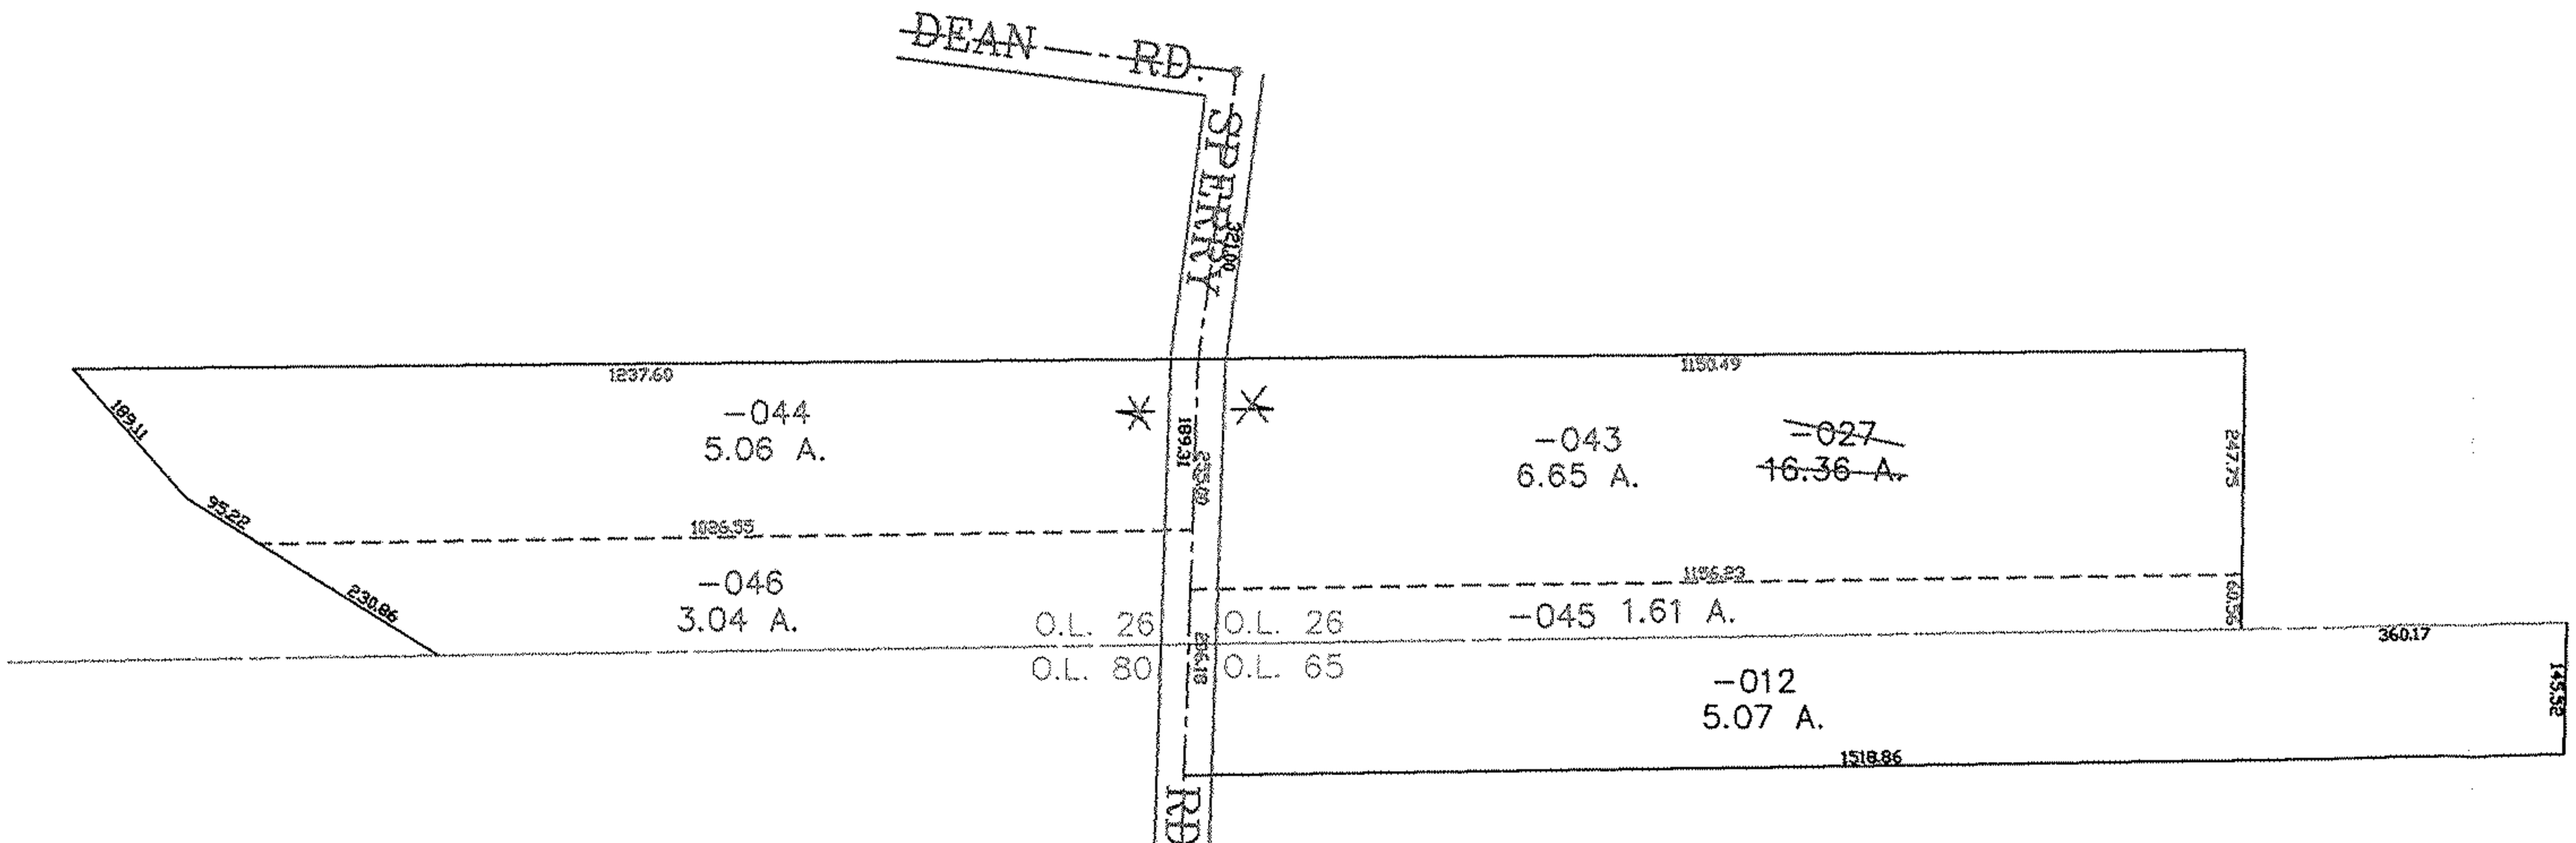
DEAN RD.
SPERRY RD.
1237.60
1150.49
-044
5.06 A.
-043
6.65 A.
-027
16.36 A.
189.11
95.22
230.86
1196.55
-046
3.04 A.
O.L. 26
O.L. 80
O.L. 26
O.L. 65
-045 1.61 A.
-012
5.07 A.
360.17
1518.86

02-01204