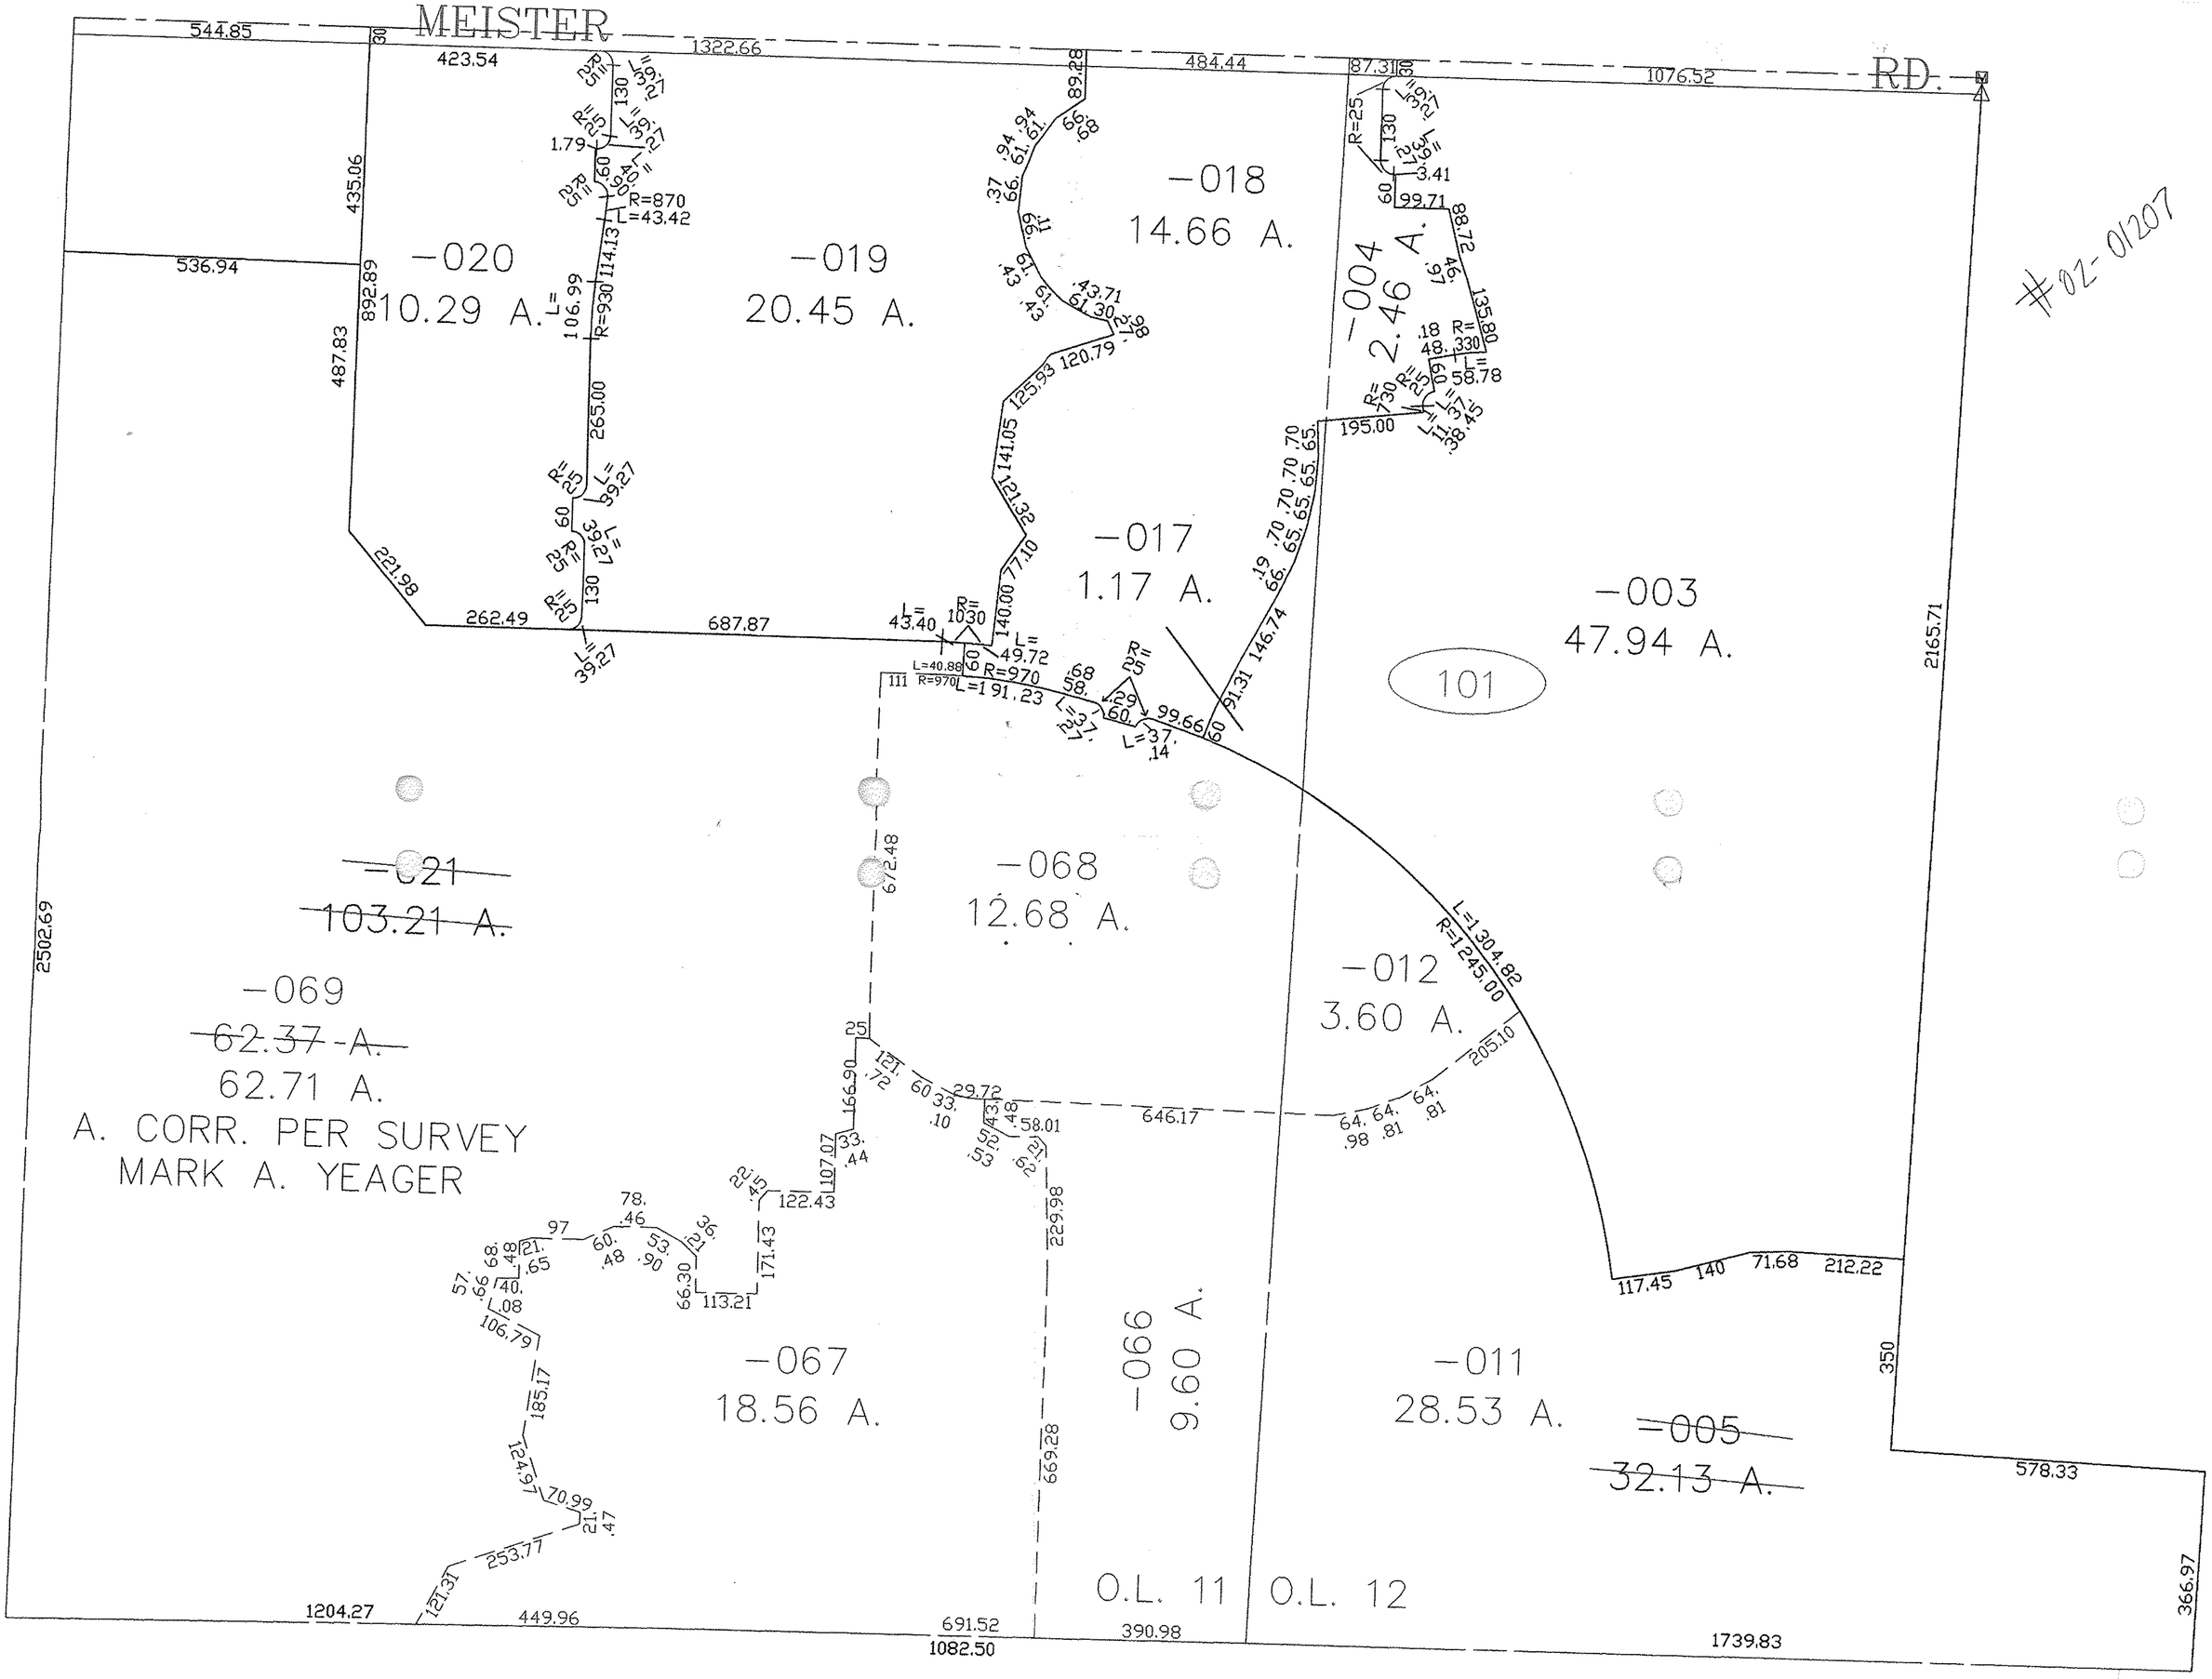
MEISTER RD.
544.85
1322.66
484.44
1076.52
423.54
435.06
536.94
892.89
487.83
221.98
262.49
687.87
2502.69
2165.71
-020
10.29 A.
-019
20.45 A.
-018
14.66 A.
-004
2.46 A.
-017
1.17 A.
-003
47.94 A.
101
~~-021~~
~~103.21 A.~~
-069
~~62.37 A.~~
62.71 A.
A. CORR. PER SURVEY
MARK A. YEAGER
-068
12.68 A.
-012
3.60 A.
-067
18.56 A.
-066
9.60 A.
-011
28.53 A.
~~-005~~
~~32.13 A.~~
O.L. 11
O.L. 12
1204.27
449.96
691.52
1082.50
390.98
1739.83
366.97
578.33
350
646.17
117.45
140
71.68
212.22
#02-01207