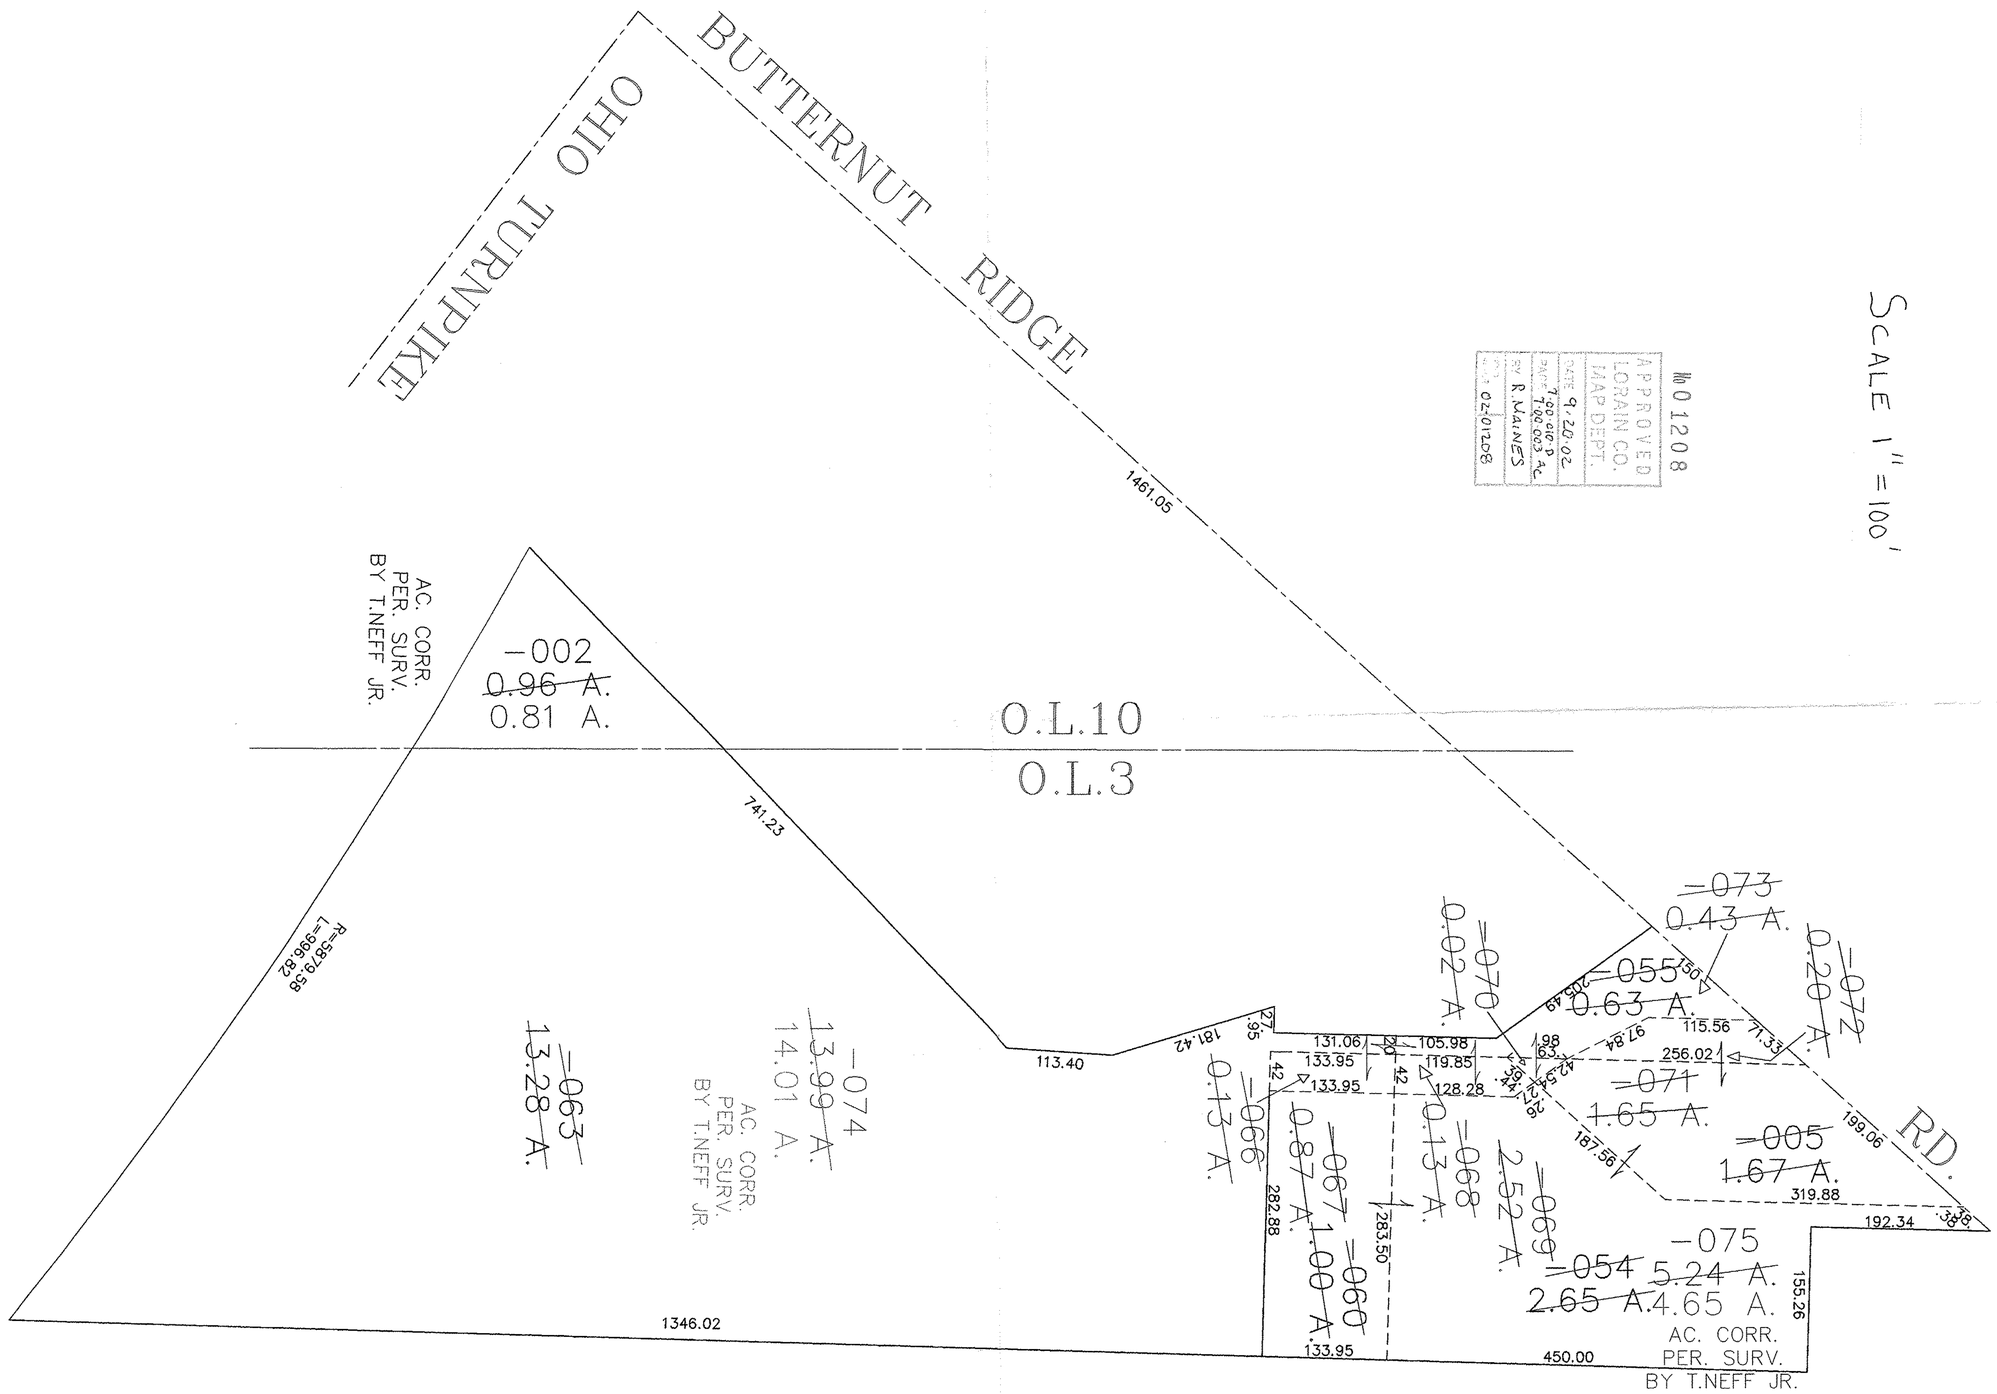
SCALE 1" = 100'
APPROVED
LORAIN CO.
MAP DEPT.
DATE 9-20-02
PARCEL T00.010 P
T00.003 AC.
BY R. MAINES
No 01208
02-01208
OHIO TURNPIKE
BUTTERNUT RIDGE RD.
1461.05
O.L.10
O.L.3
741.23
R=5879.58
L=996.82
113.40
181.42
27.95
1346.02
-002
~~0.96 A.~~
0.81 A.
AC. CORR.
PER. SURV.
BY T.NEFF JR.
~~-063~~
~~13.28 A.~~
-074
~~13.99 A.~~
14.01 A.
AC. CORR.
PER. SURV.
BY T.NEFF JR.
~~-066~~
~~0.13 A.~~
~~-067~~
~~0.87 A.~~
~~-060~~
~~1.00 A.~~
~~-070~~
~~0.02 A.~~
~~-068~~
~~0.13 A.~~
~~-069~~
~~2.52 A.~~
~~-054~~ ~~5.24 A.~~
~~2.65 A.~~ 4.65 A.
-075
AC. CORR.
PER. SURV.
BY T.NEFF JR.
~~-055~~
~~0.63 A.~~
~~-073~~
~~0.43 A.~~
~~-072~~
~~0.20 A.~~
~~-071~~
~~1.65 A.~~
~~-005~~
~~1.67 A.~~
131.06
133.95
105.98
119.85
128.28
133.95
42
42
20
282.88
283.50
133.95
450.00
155.26
192.34
319.88
199.06
256.02
115.56
71.33
97.84
205.49
157.56
26.54
44.71
39.63
98
50
38