#02-012 Ip

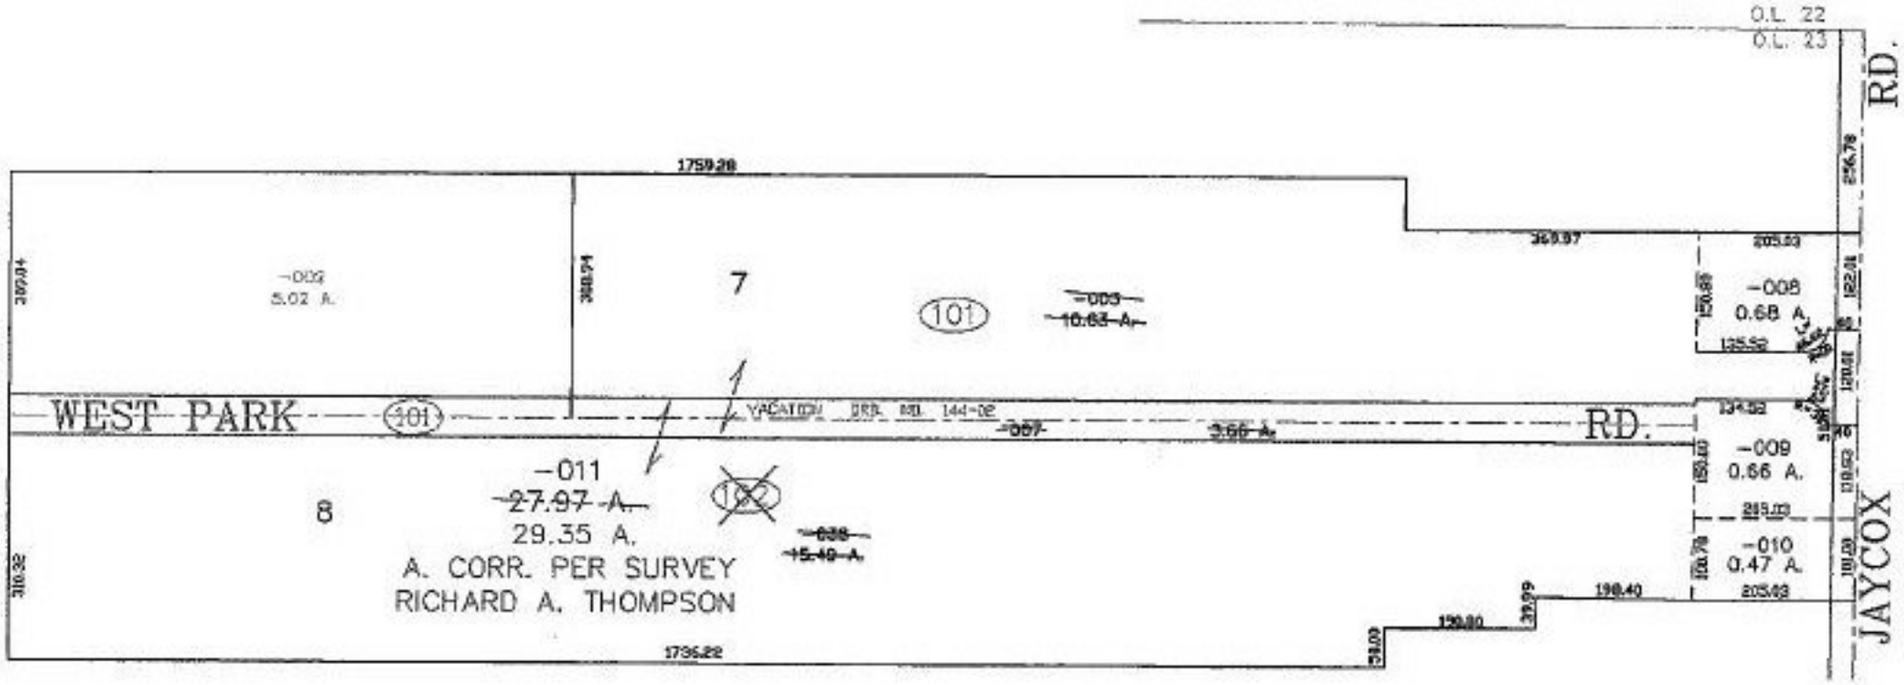
O.L. 22
O.L. 23
RD.
1759.28
-009
5.02 A.
7
101
-005
~~10.63 A.~~
-008
0.68 A.
WEST PARK
101
YACATON DRN. RD. 144-02
-007
~~3.66 A.~~
RD.
-009
0.66 A.
8
-011
~~27.97 A.~~
29.35 A.
A. CORR. PER SURVEY
RICHARD A. THOMPSON
~~-006~~
~~15.49 A.~~
-010
0.47 A.
1736.22
JAYCOX