RASTER

PARENT PARCEL: 06-24-085-103-018, -007
CHILD PARCEL: 06-24-085-103-019 THRU -023
STARTING POINT: CENTERLINE OF LAKE AVE. & RUSH ST.

NO. 01223

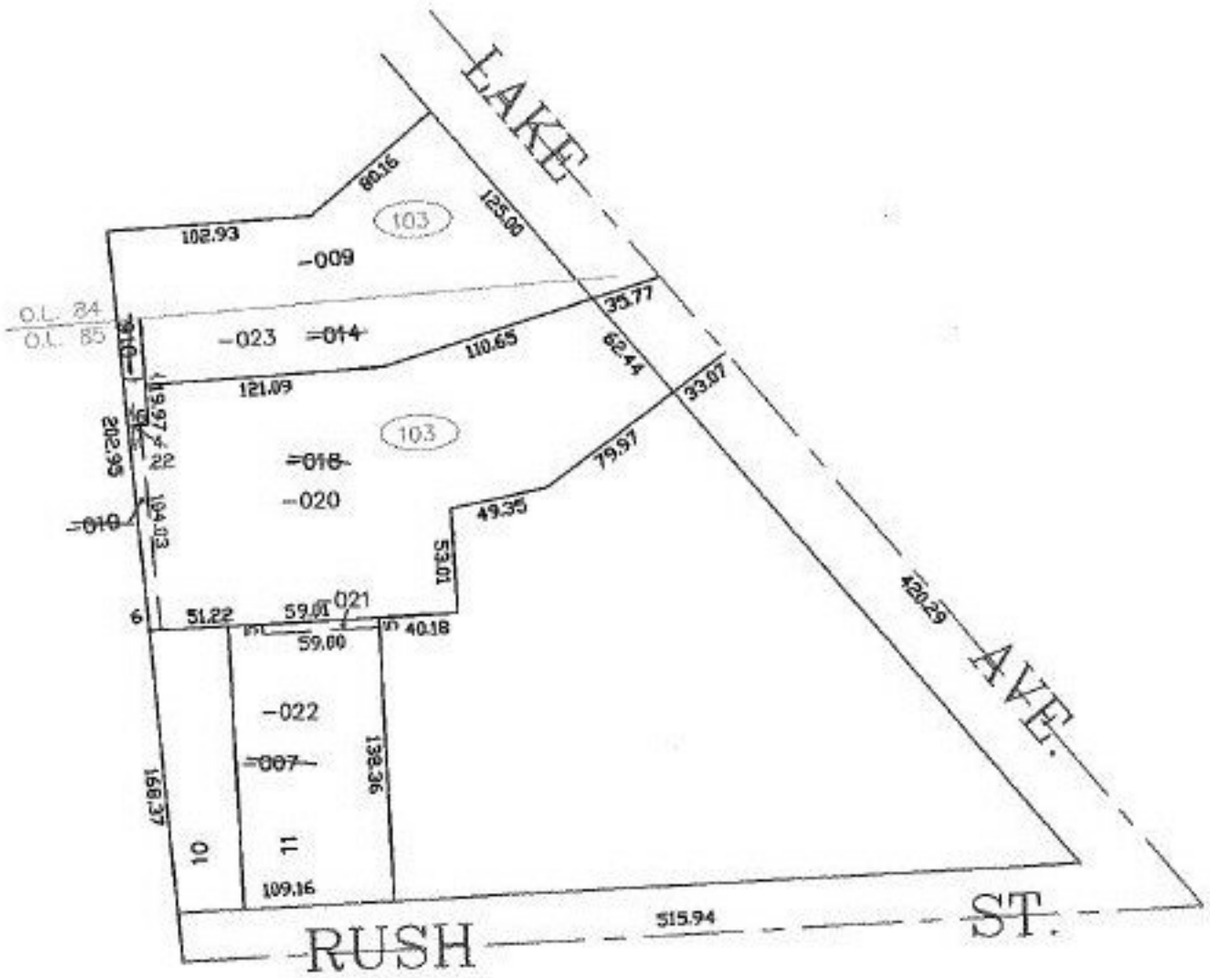

SPLITS/DEEDS PROCESSED

LORAIN COUNTY TAX MAP DEPARTMENT
226 MIDDLE AVE. ELYRIA, OHIO

SURVEYED BY: THOMAS A. SIMON
CLOSURE: 0.00 : 10,000
MAP PAGE(S): 6-81, 6-99
APPROVED BY: JAH DATE: 10-10-02
SCALE: 1" = 100 PRIOR INSTRUMENT: 990597523