02-01230

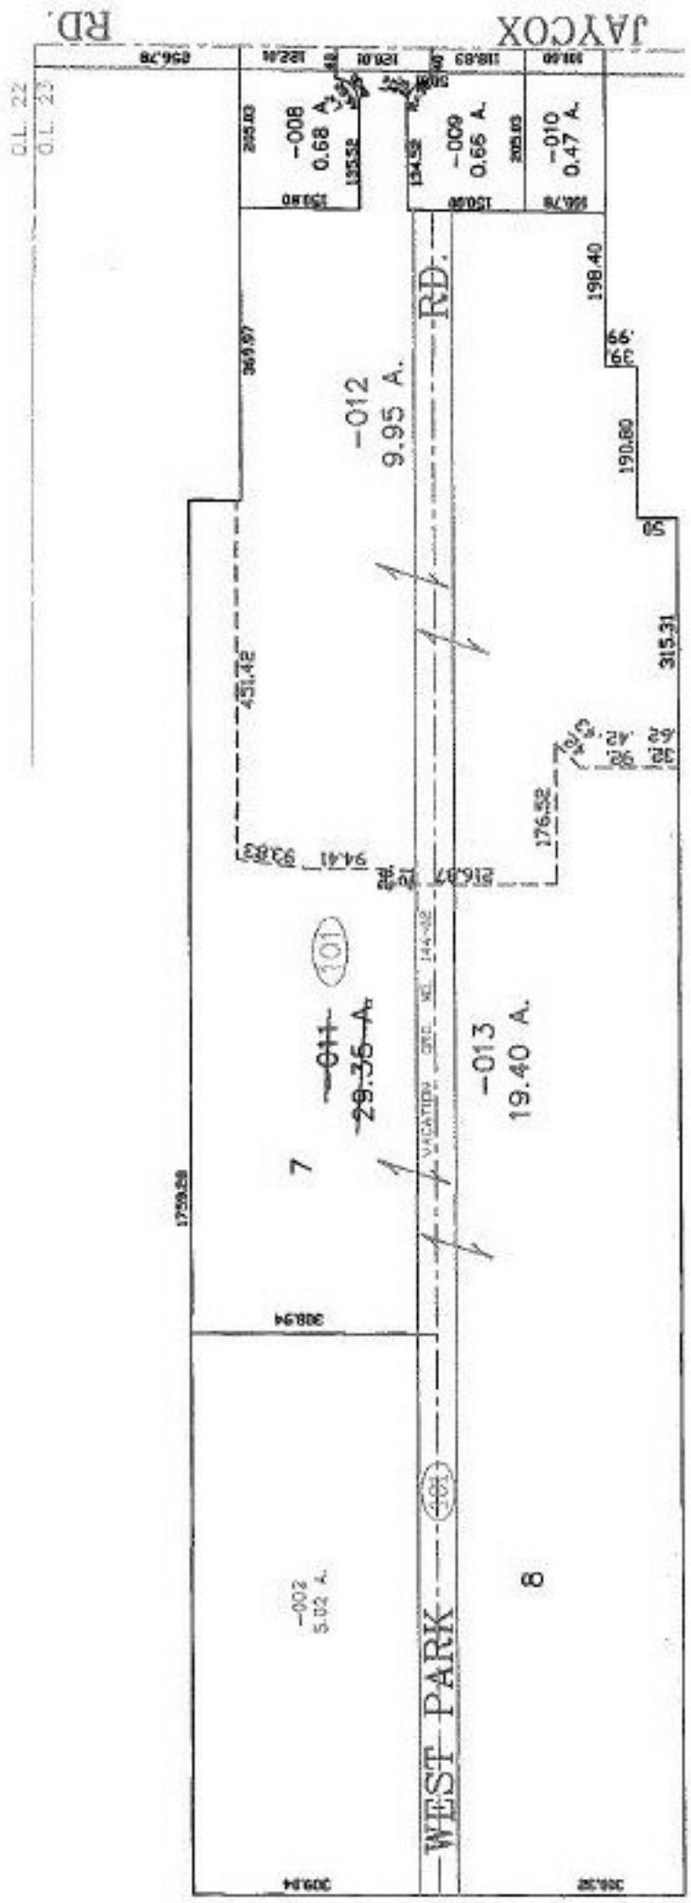
JAYCOX
RD.
O.L. 22
O.L. 23
-008
0.68 A.
-009
0.65 A.
-010
0.47 A.
-012
9.95 A.
RD.
198.40
39.99
190.80
315.31
431.42
369.97
176.52
216.37
94.41
93.83
101
-011
29.35 A.
-013
19.40 A.
7
VACATION ORD. NO. 144-92
1759.28
308.94
-002
5.02 A.
WEST PARK
401
8
309.94
309.92