02-01257

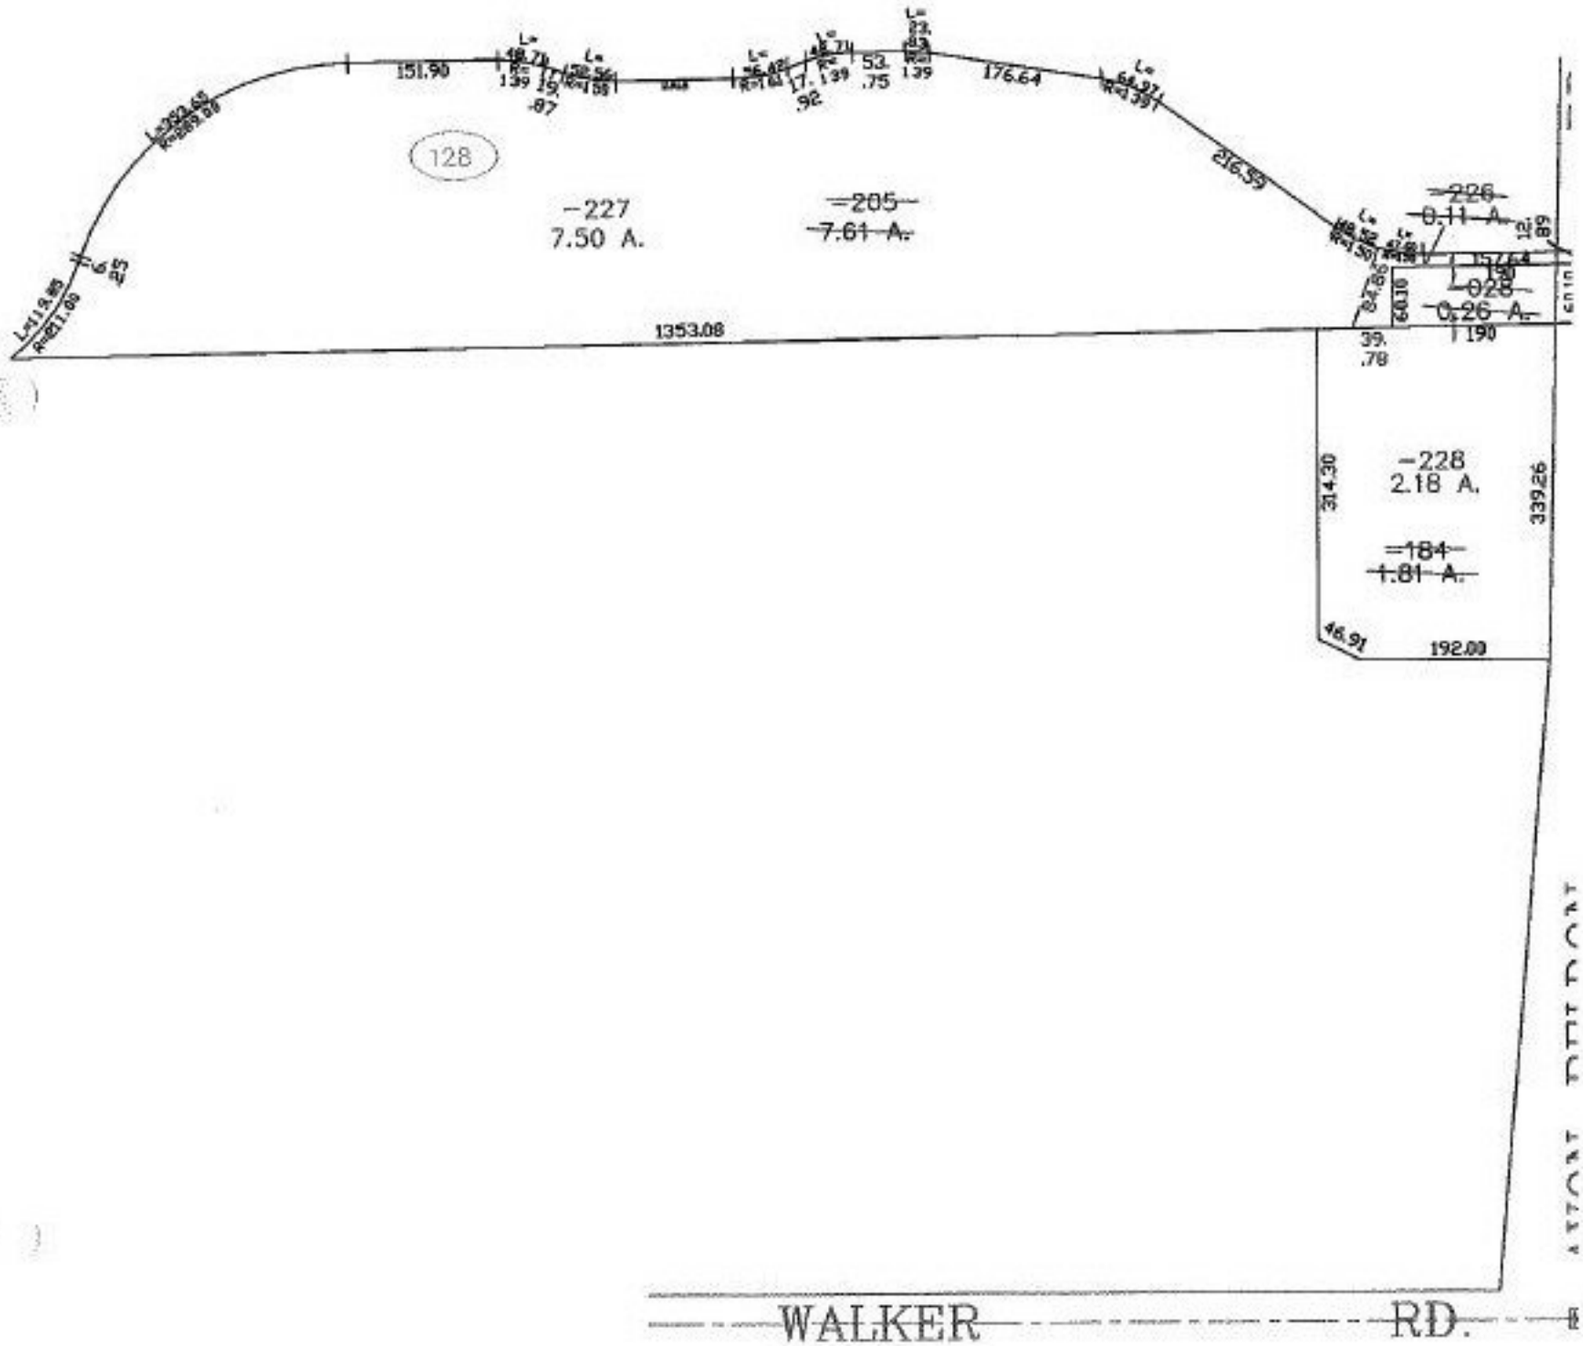
128
-227
7.50 A.
-205
7.61 A.
-226
0.11 A.
-028
0.26 A.
-228
2.18 A.
-184
1.81 A.
1353.08
151.90
176.64
216.59
314.30
339.26
192.00
WALKER RD.