02-01272

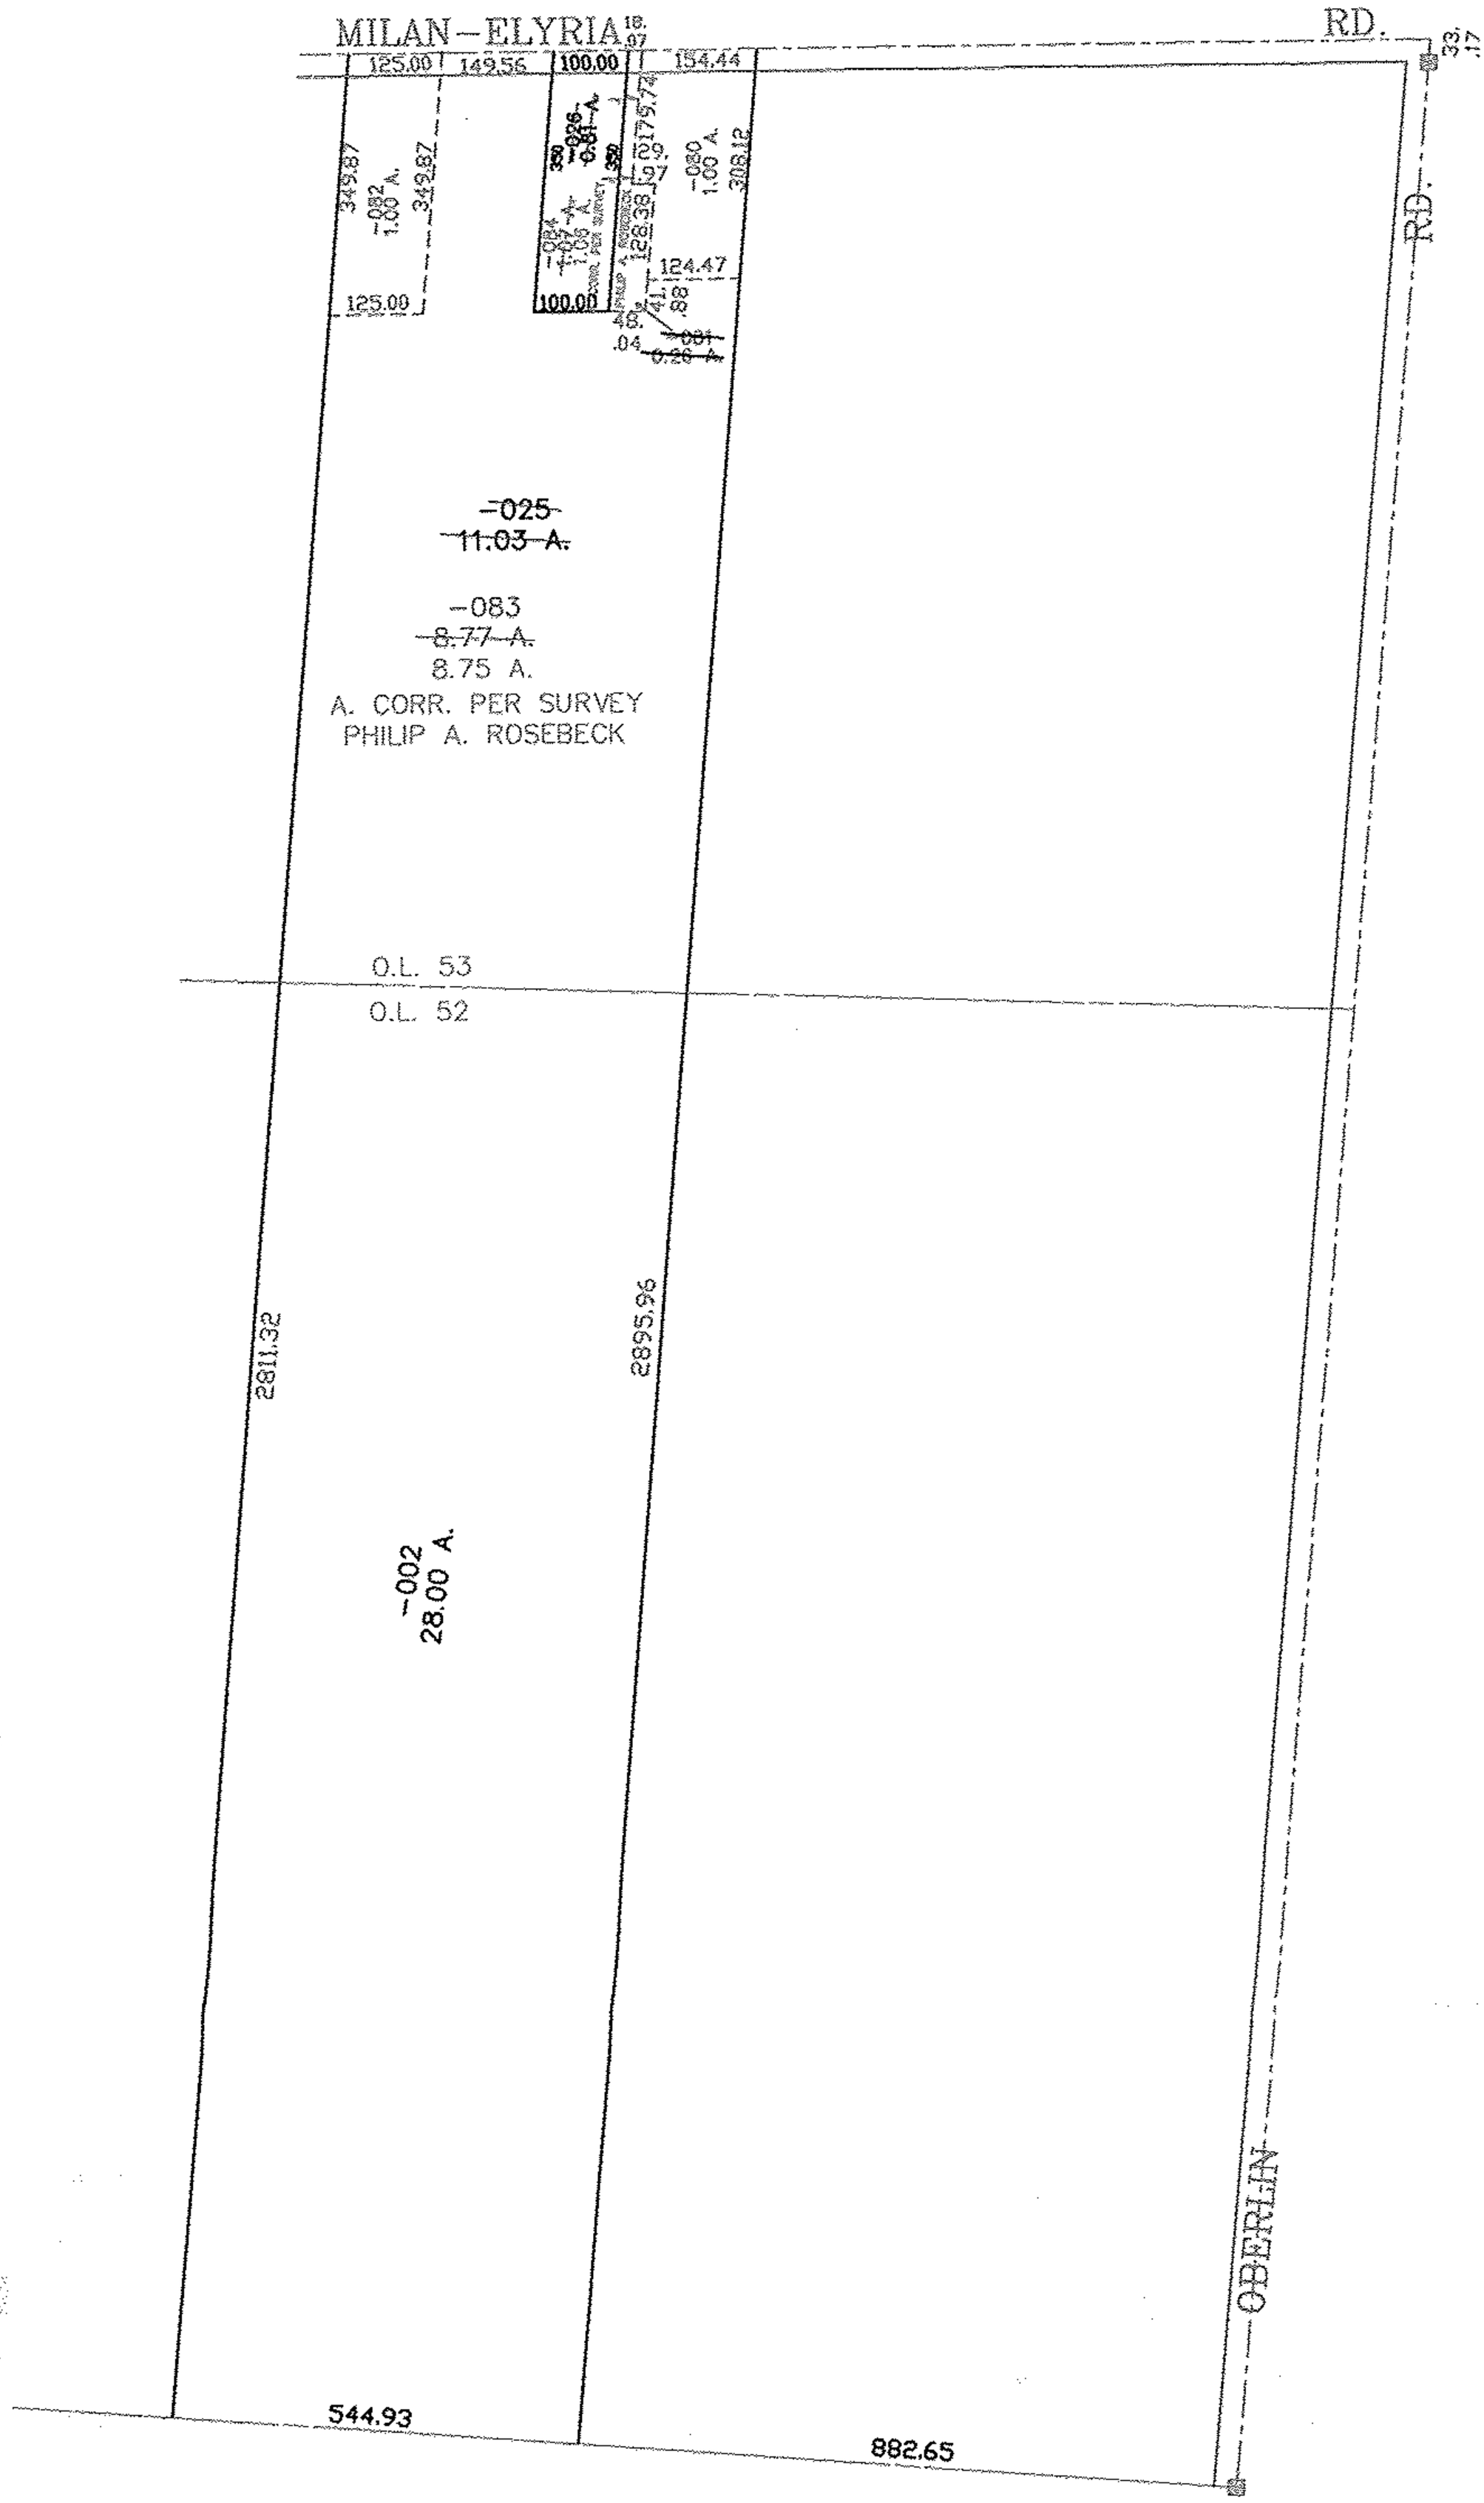
MILAN-ELYRIA 18/07
RD.
125.00
149.56
100.00
154.44
349.87
-082
1.00 A.
349.87
125.00
100.00
-080
1.00 A.
306.12
124.47
~~-025~~
~~11.03 A.~~
-083
~~8.77 A.~~
8.75 A.
A. CORR. PER SURVEY
PHILIP A. ROSEBECK
O.L. 53
O.L. 52
2811.32
2895.96
-002
28.00 A.
544.93
882.65
OBERLIN RD.