RASTER

PARENT PARCEL: 06-24-100-000-029,06-24-101-000-026
CHILD PARCEL: 06-24-100-000-030,06-24-101-000-028 THRU -030
STARTING POINT: INTERSECTION OF NORTH R.O.W. LINE OF WOODFORD AVE. AND WEST R.O.W. OF WEST RIVER RD.

NO. 01280

N
W E
S

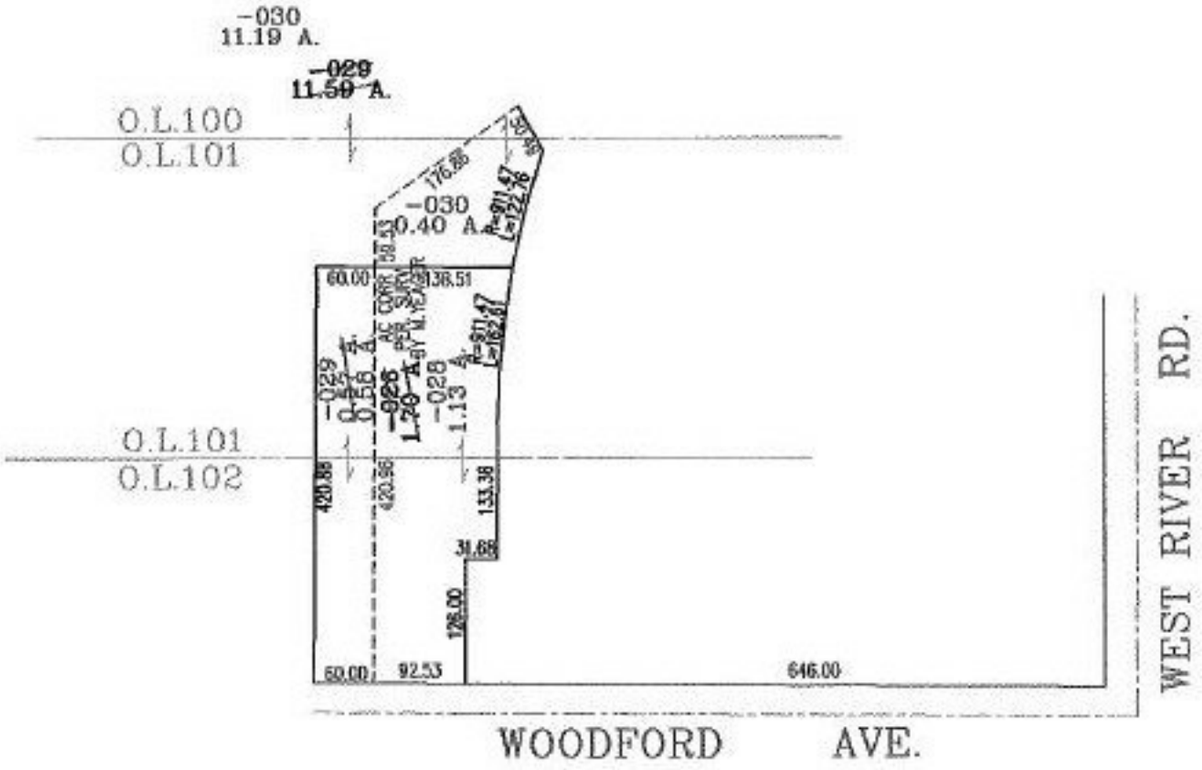

SPLITS/DEEDS PROCESSED
LORAIN COUNTY TAX MAP DEPARTMENT
226 MIDDLE AVE. ELYRIA, OHIO

SURVEYED BY: MARK ALLEN YEAGER
CLOSURE: .01:10,000
MAP PAGE(S): 6-117
APPROVED BY: RRM DATE: 12-31-02
SCALE: 1"= 200 PRIOR INSTRUMENT: DV 1082/920