RASTER

PARENT PARCEL: 06-24-011-000-019
CHILD PARCEL: 06-24-011-000-020,06-24-099-000-033
STARTING POINT: SOUTHWEST CORNER OF O.L.99

NO. 01281

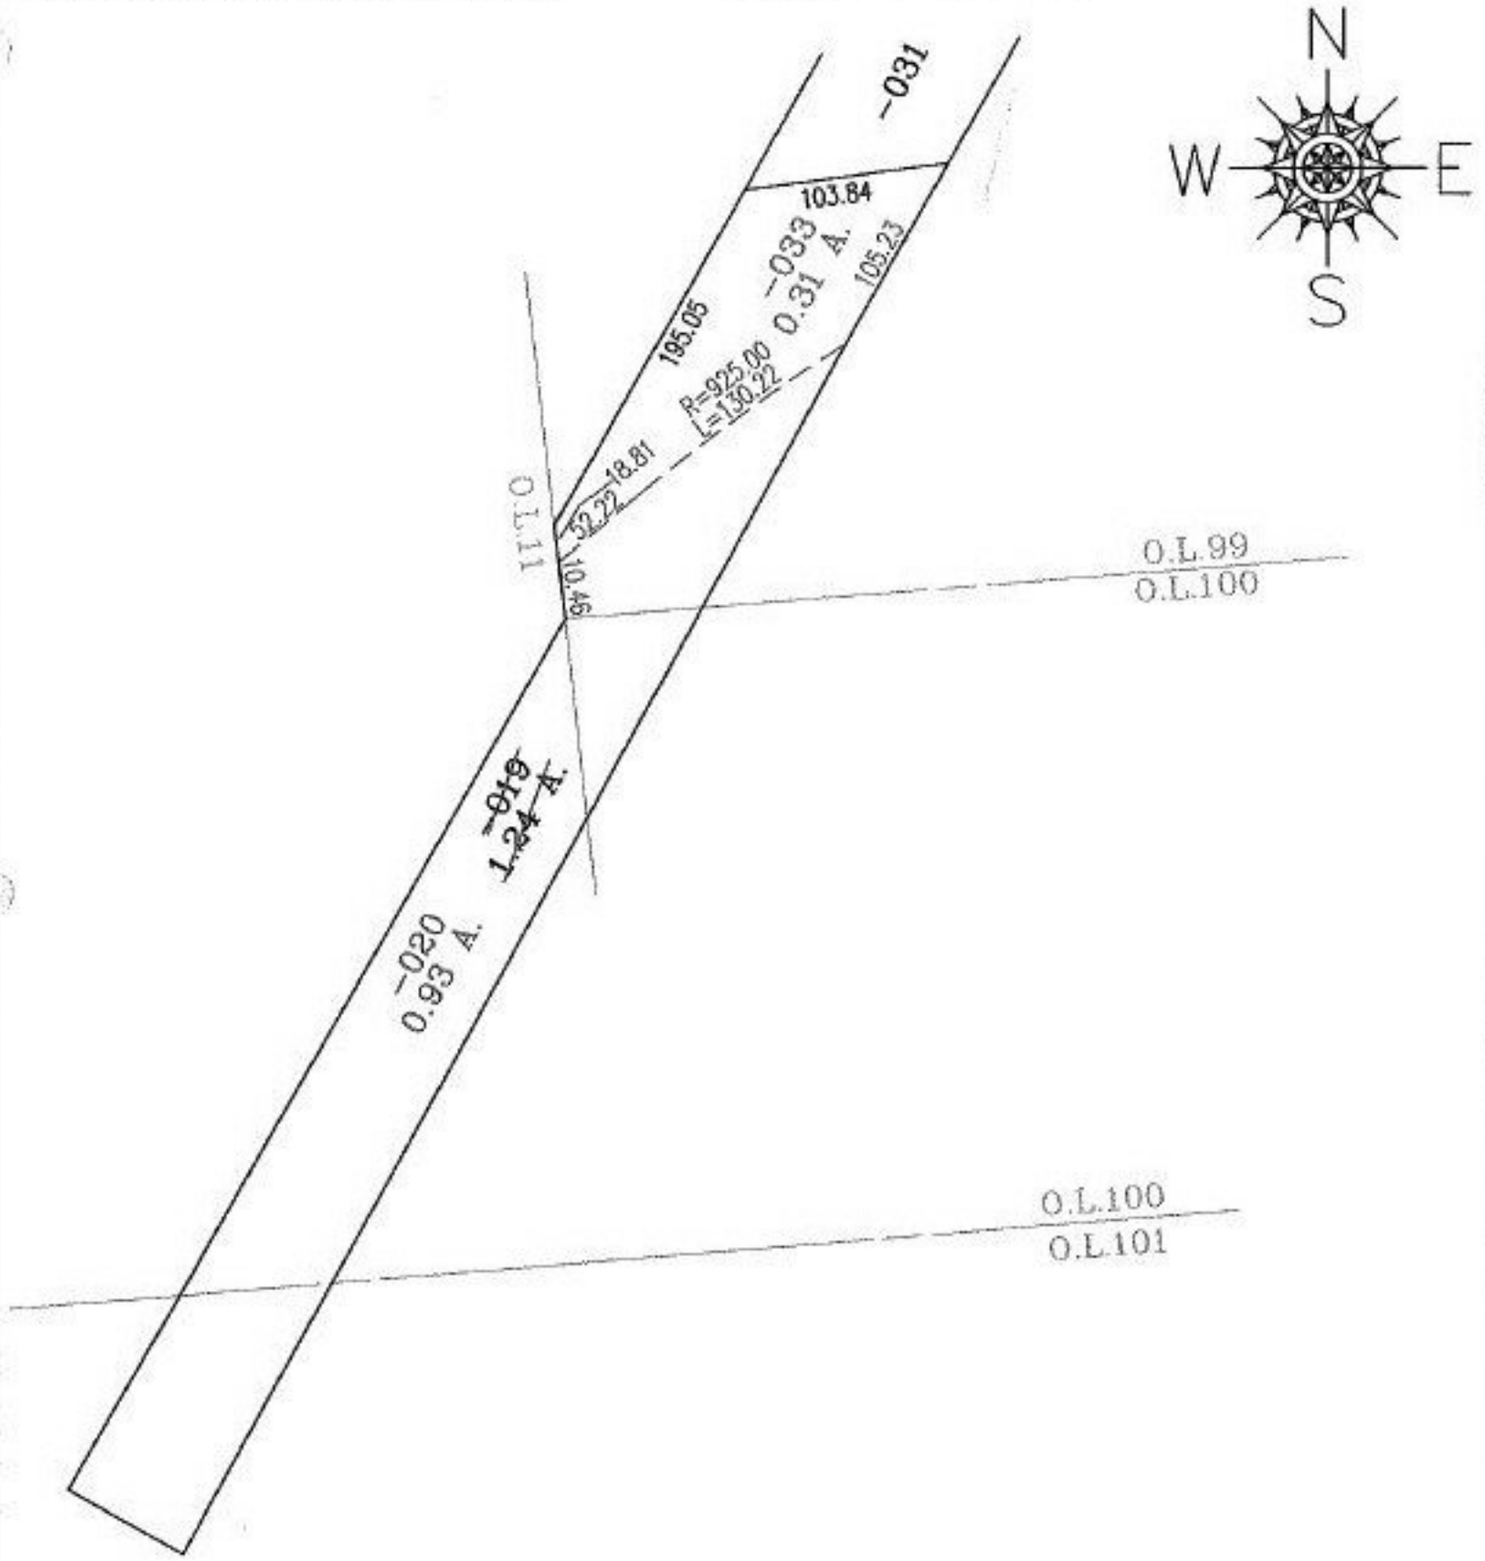

SPLITS/DEEDS PROCESSED

LORAIN COUNTY TAX MAP DEPARTMENT
226 MIDDLE AVE. ELYRIA, OHIO

SURVEYED BY: MARK ALLEN YEAGER
CLOSURE: .02:10,000
MAP PAGE(S): 6-116
APPROVED BY: RRM DATE: 1-9-03
SCALE: 1"= 100 PRIOR INSTRUMENT: 970491740