RASTER

05-02008

PARENT PARCEL: ** SEE BELOW

CHILD PARCEL: *SEE BELOW

STARTING POINT: CENTER LINE OF BAIRD RD. & WAKEMAN-LAGRANGE-RICHFIELD RD.

**13-09-017-000-002, 13-09-018-000-004, 13-09-020-000-001, 13-09-019-000-002

*13-09-017-000-003 THRU -006
*13-09-018-000-014, -015
*13-09-019-000-005 THRU -008
*13-09-020-000-002 THRU -007

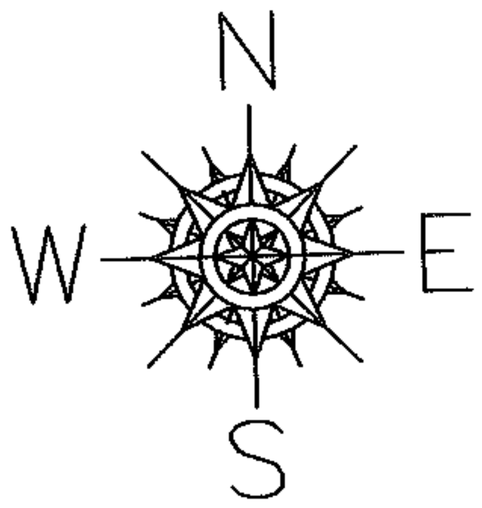

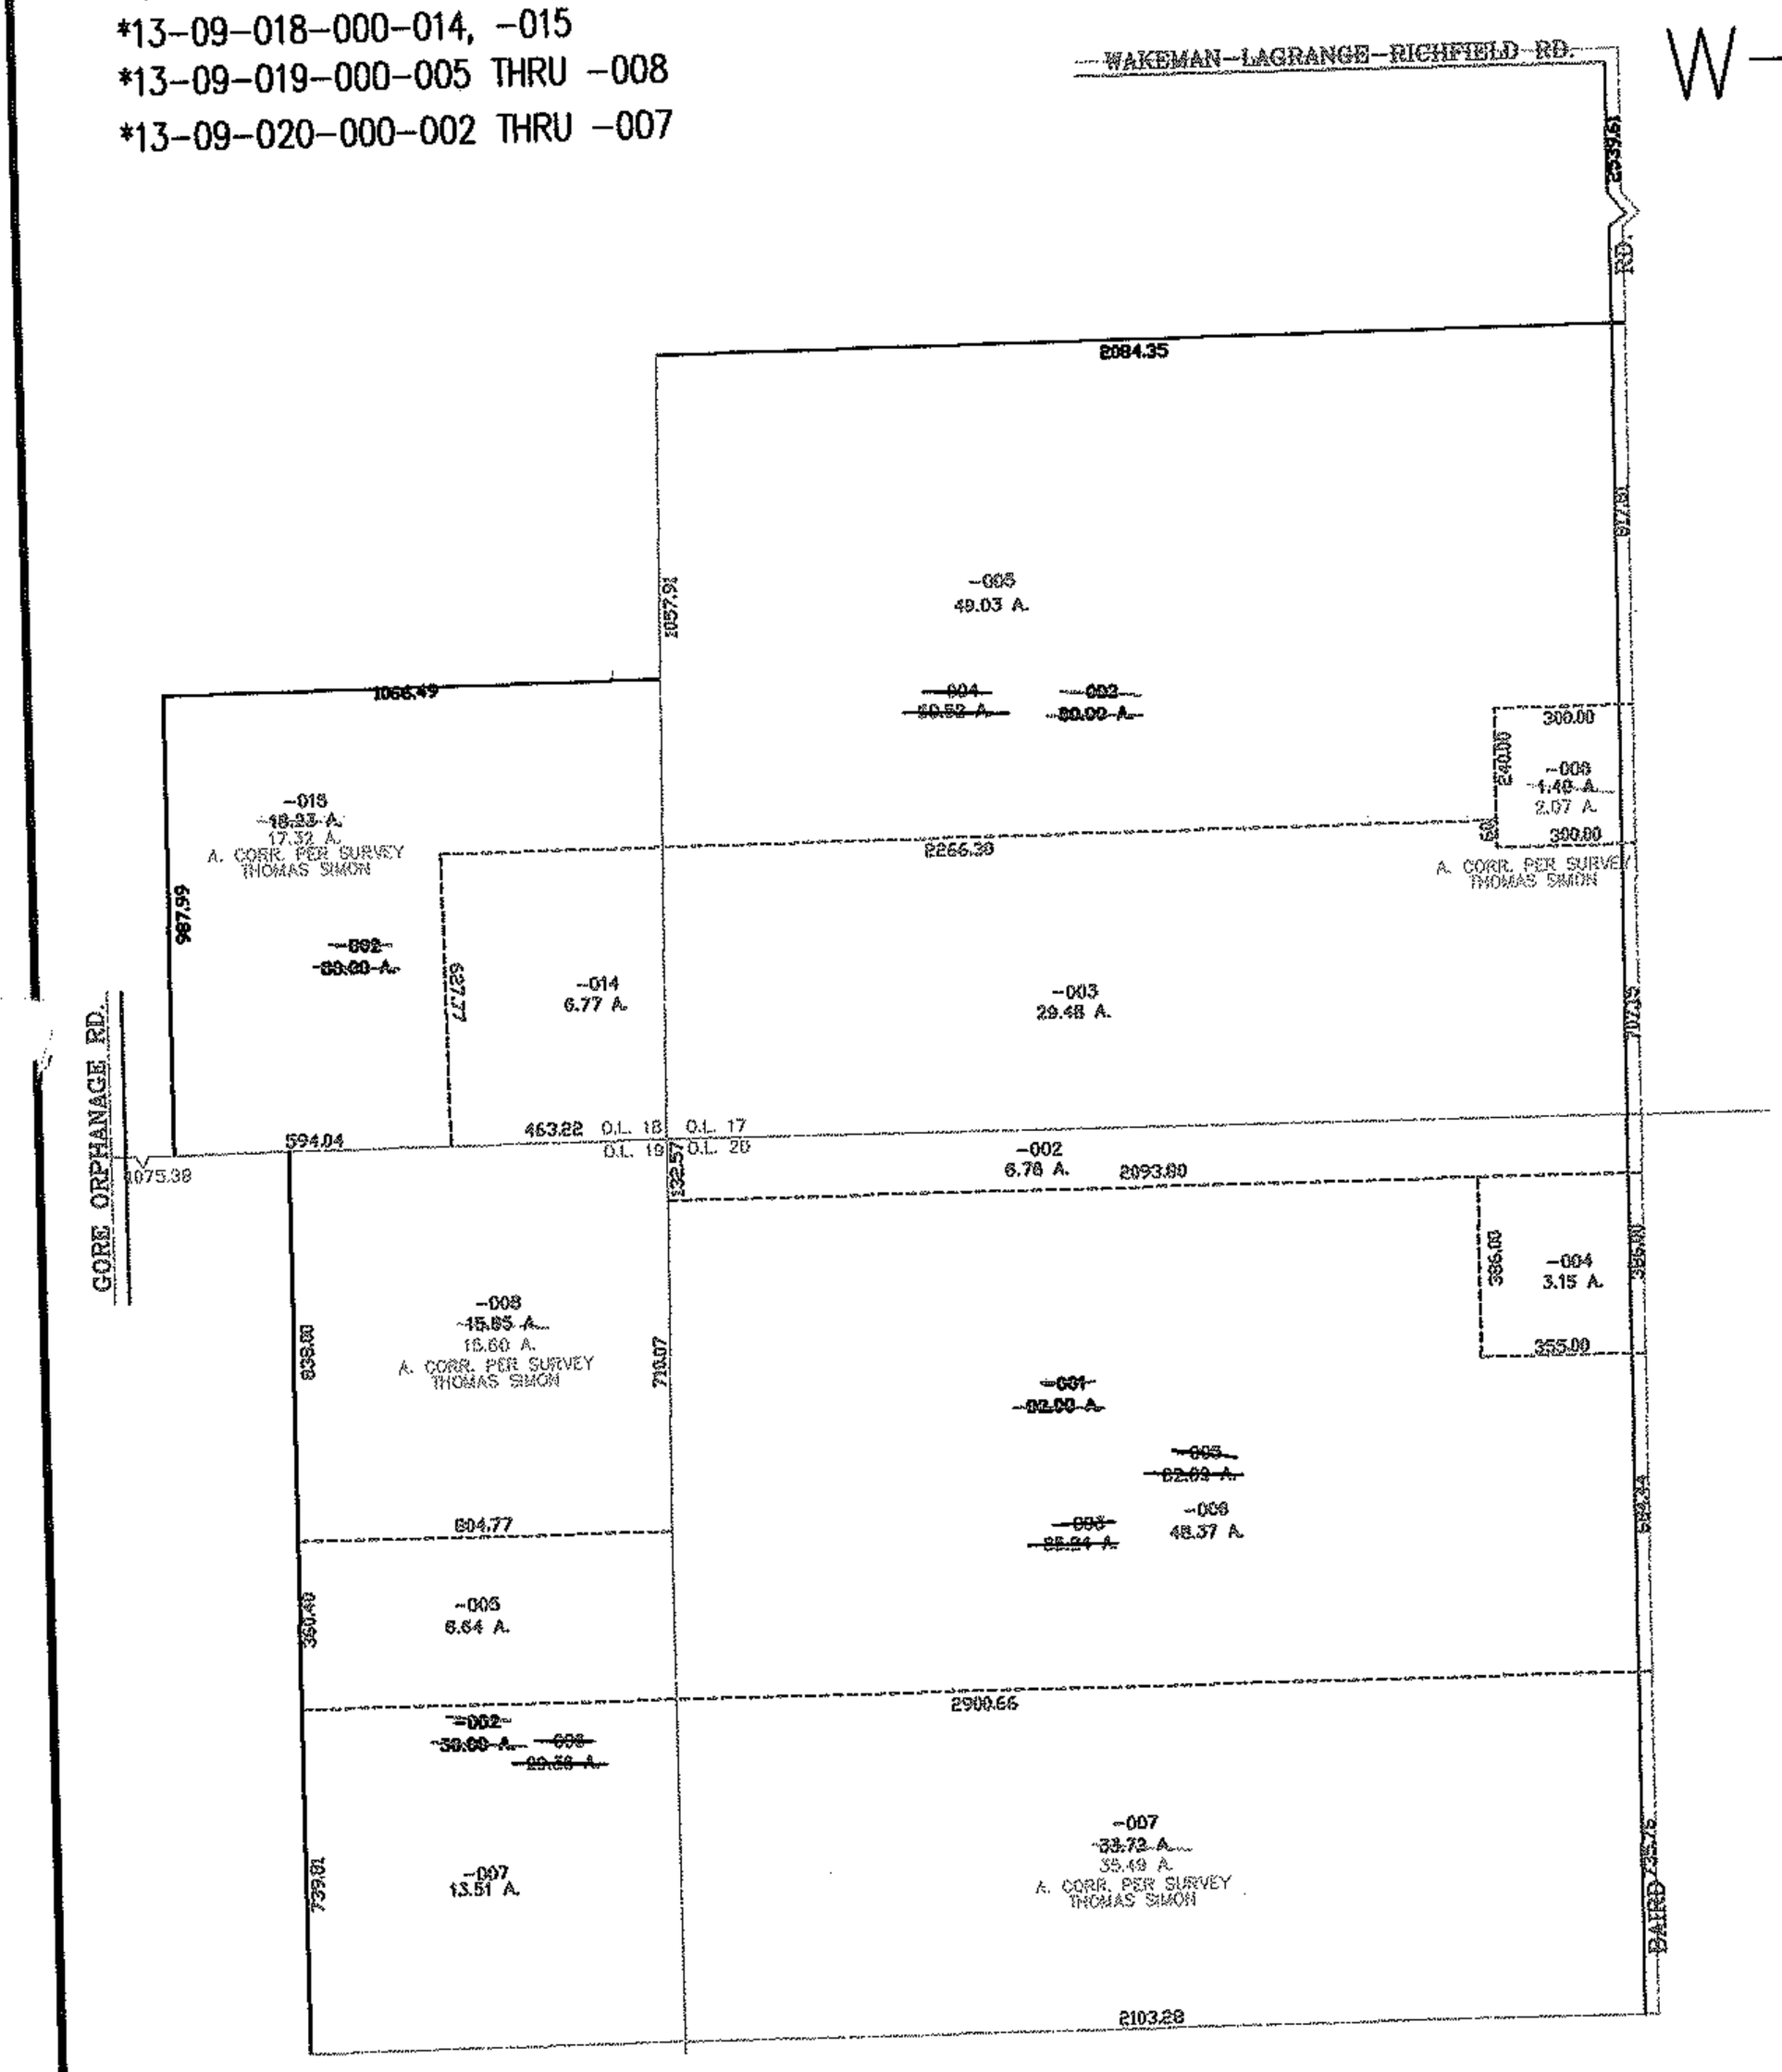

SPLITS/DEEDS PROCESSED

LORAIN COUNTY TAX MAP DEPARTMENT
226 MIDDLE AVE. ELYRIA, OHIO

SURVEYED BY: THOMAS SIMON
CLOSURE: 0.01 : 10,000
MAP PAGE(S): 13-E
APPROVED BY: JAH DATE: 9-22-05
SCALE: 1"= 600 PRIOR INSTRUMENT: 20040997957