RASTER

PARENT PARCEL: 05-00-044-000-014, -027, -052

CHILD PARCEL: 05-00-044-000-087 TRU -092

STARTING POINT: CENTERLINE OF DEWEY RD. & O.L. 44

05-02023

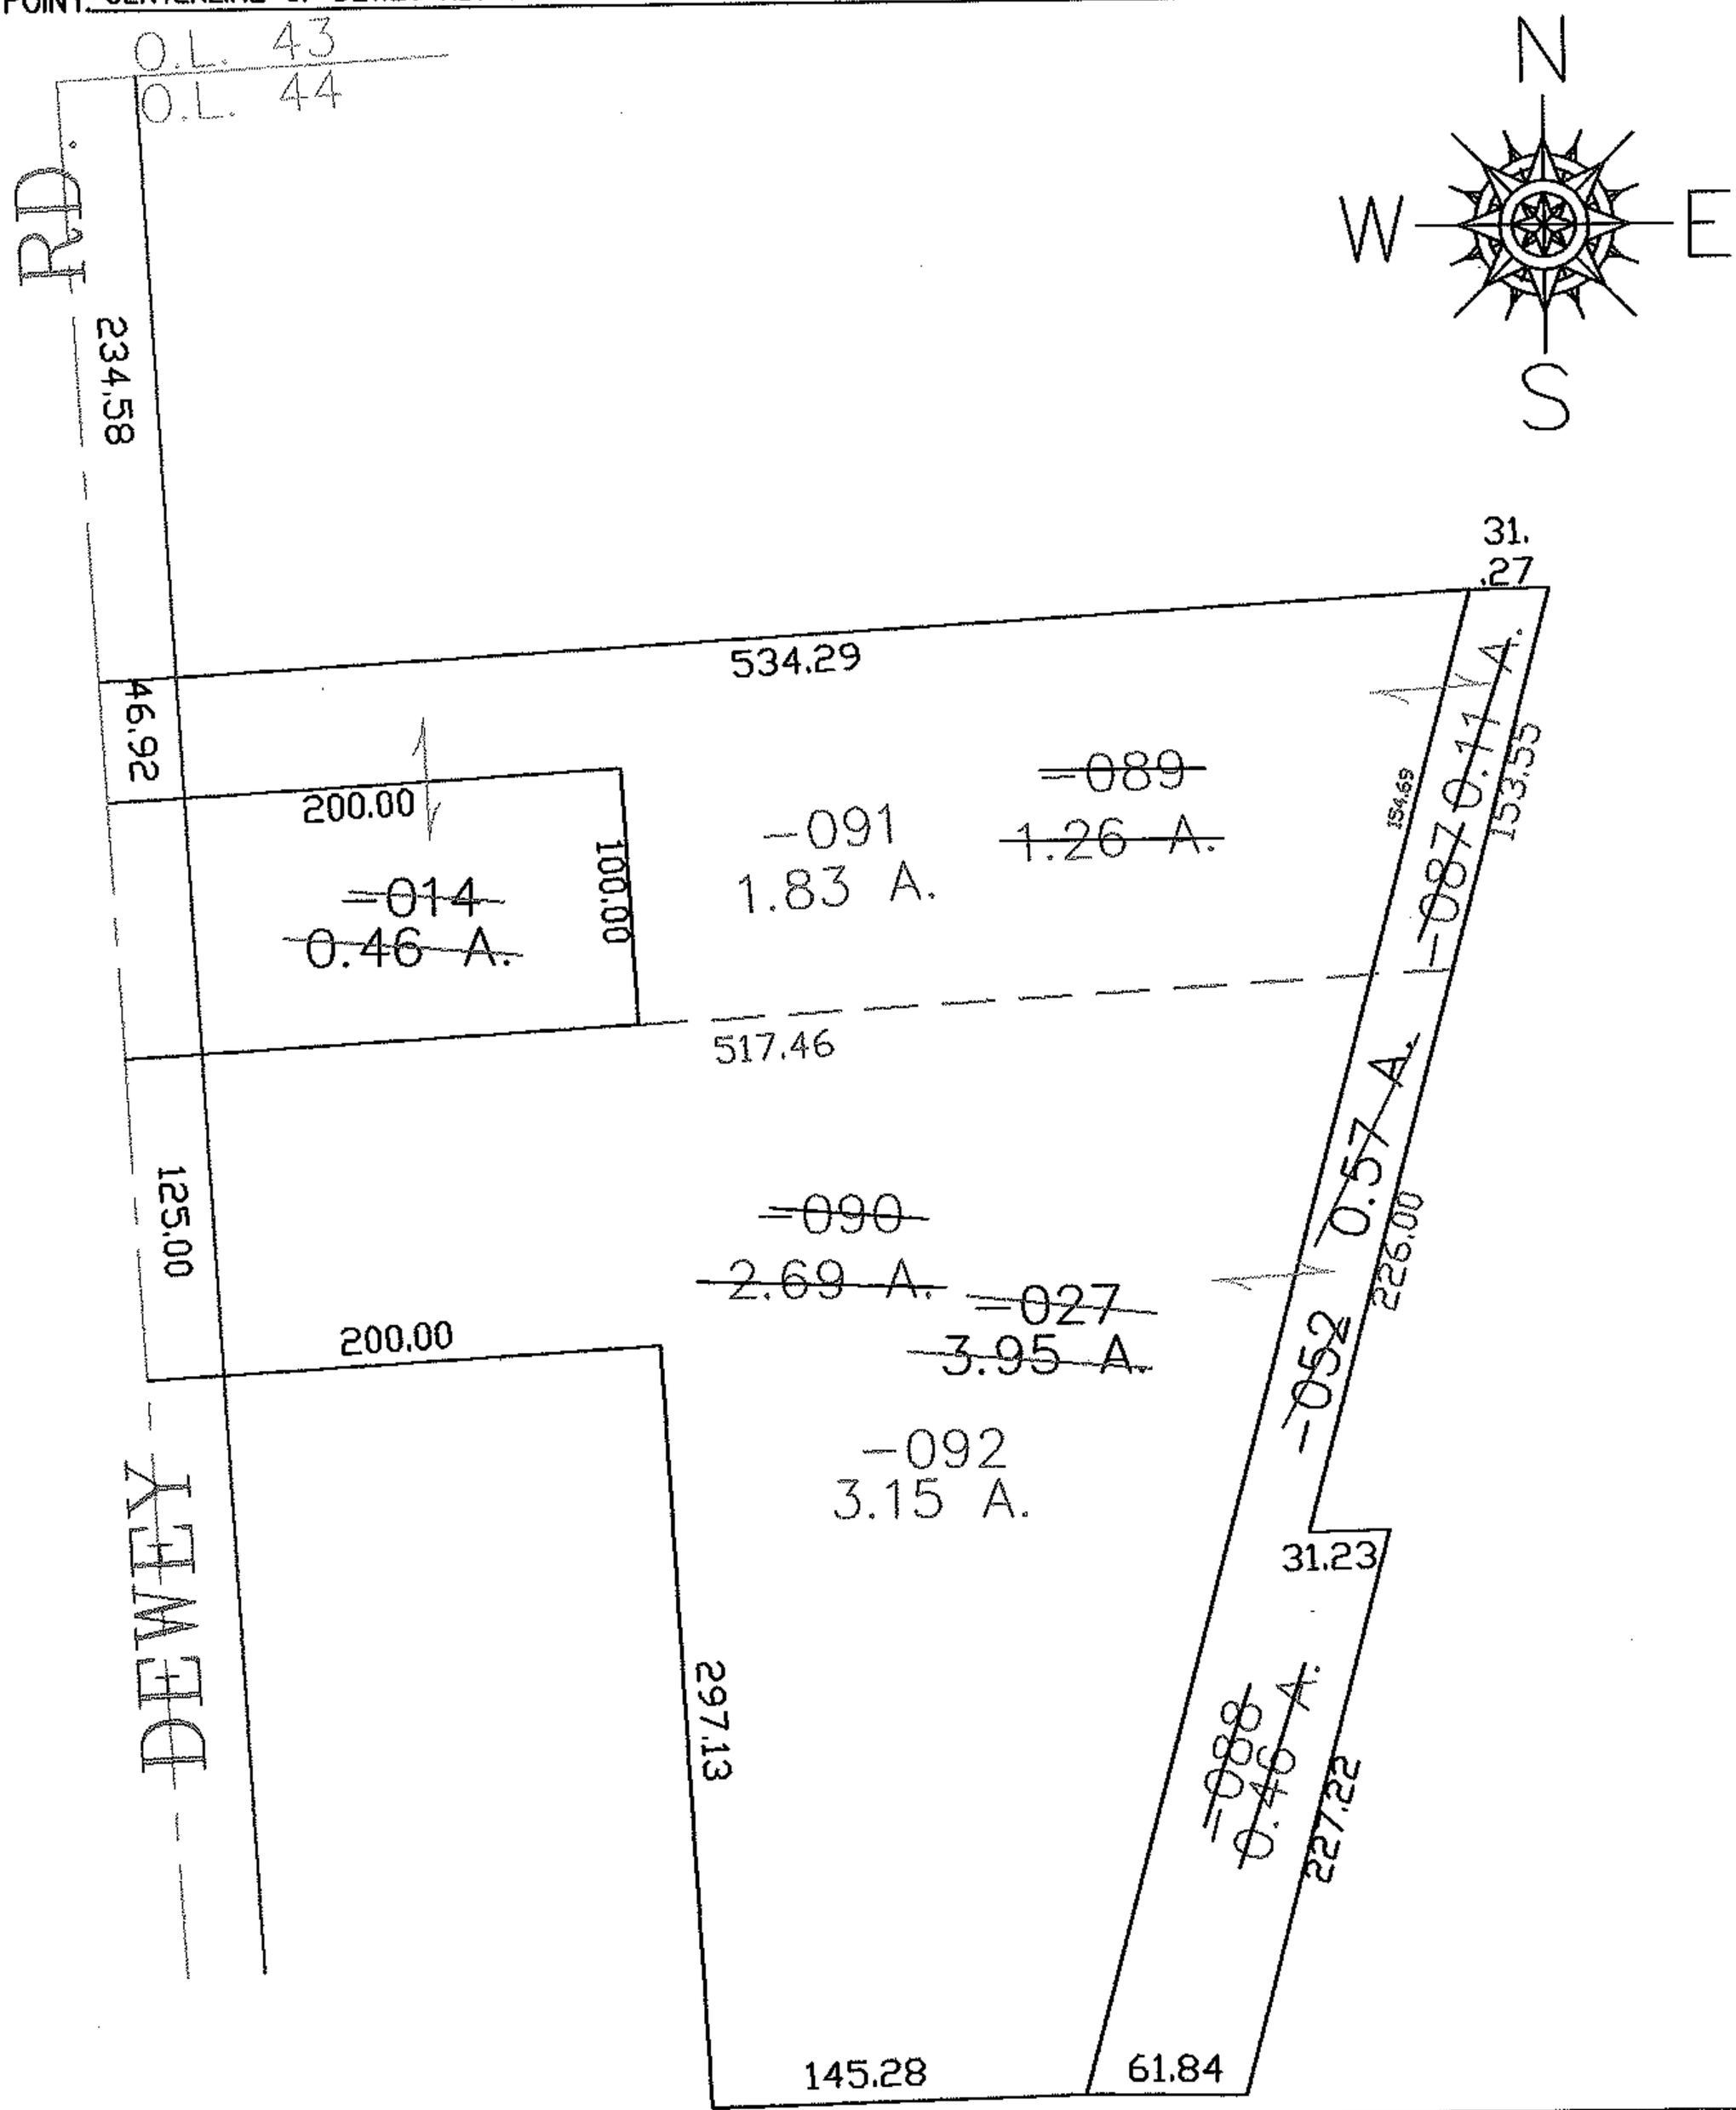

SPLITS/DEEDS PROCESSED

LORAIN COUNTY TAX MAP DEPARTMENT
226 MIDDLE AVE. ELYRIA, OHIO

SURVEYED BY: CHARLES WARYU

CLOSURE: 0.00 : 10,000

MAP PAGE(S): 05-00-044-B

APPROVED BY: JAH DATE: 10-18-05

SCALE: 1"= 100 PRIOR INSTRUMENT: DV 1327/607