05-02042

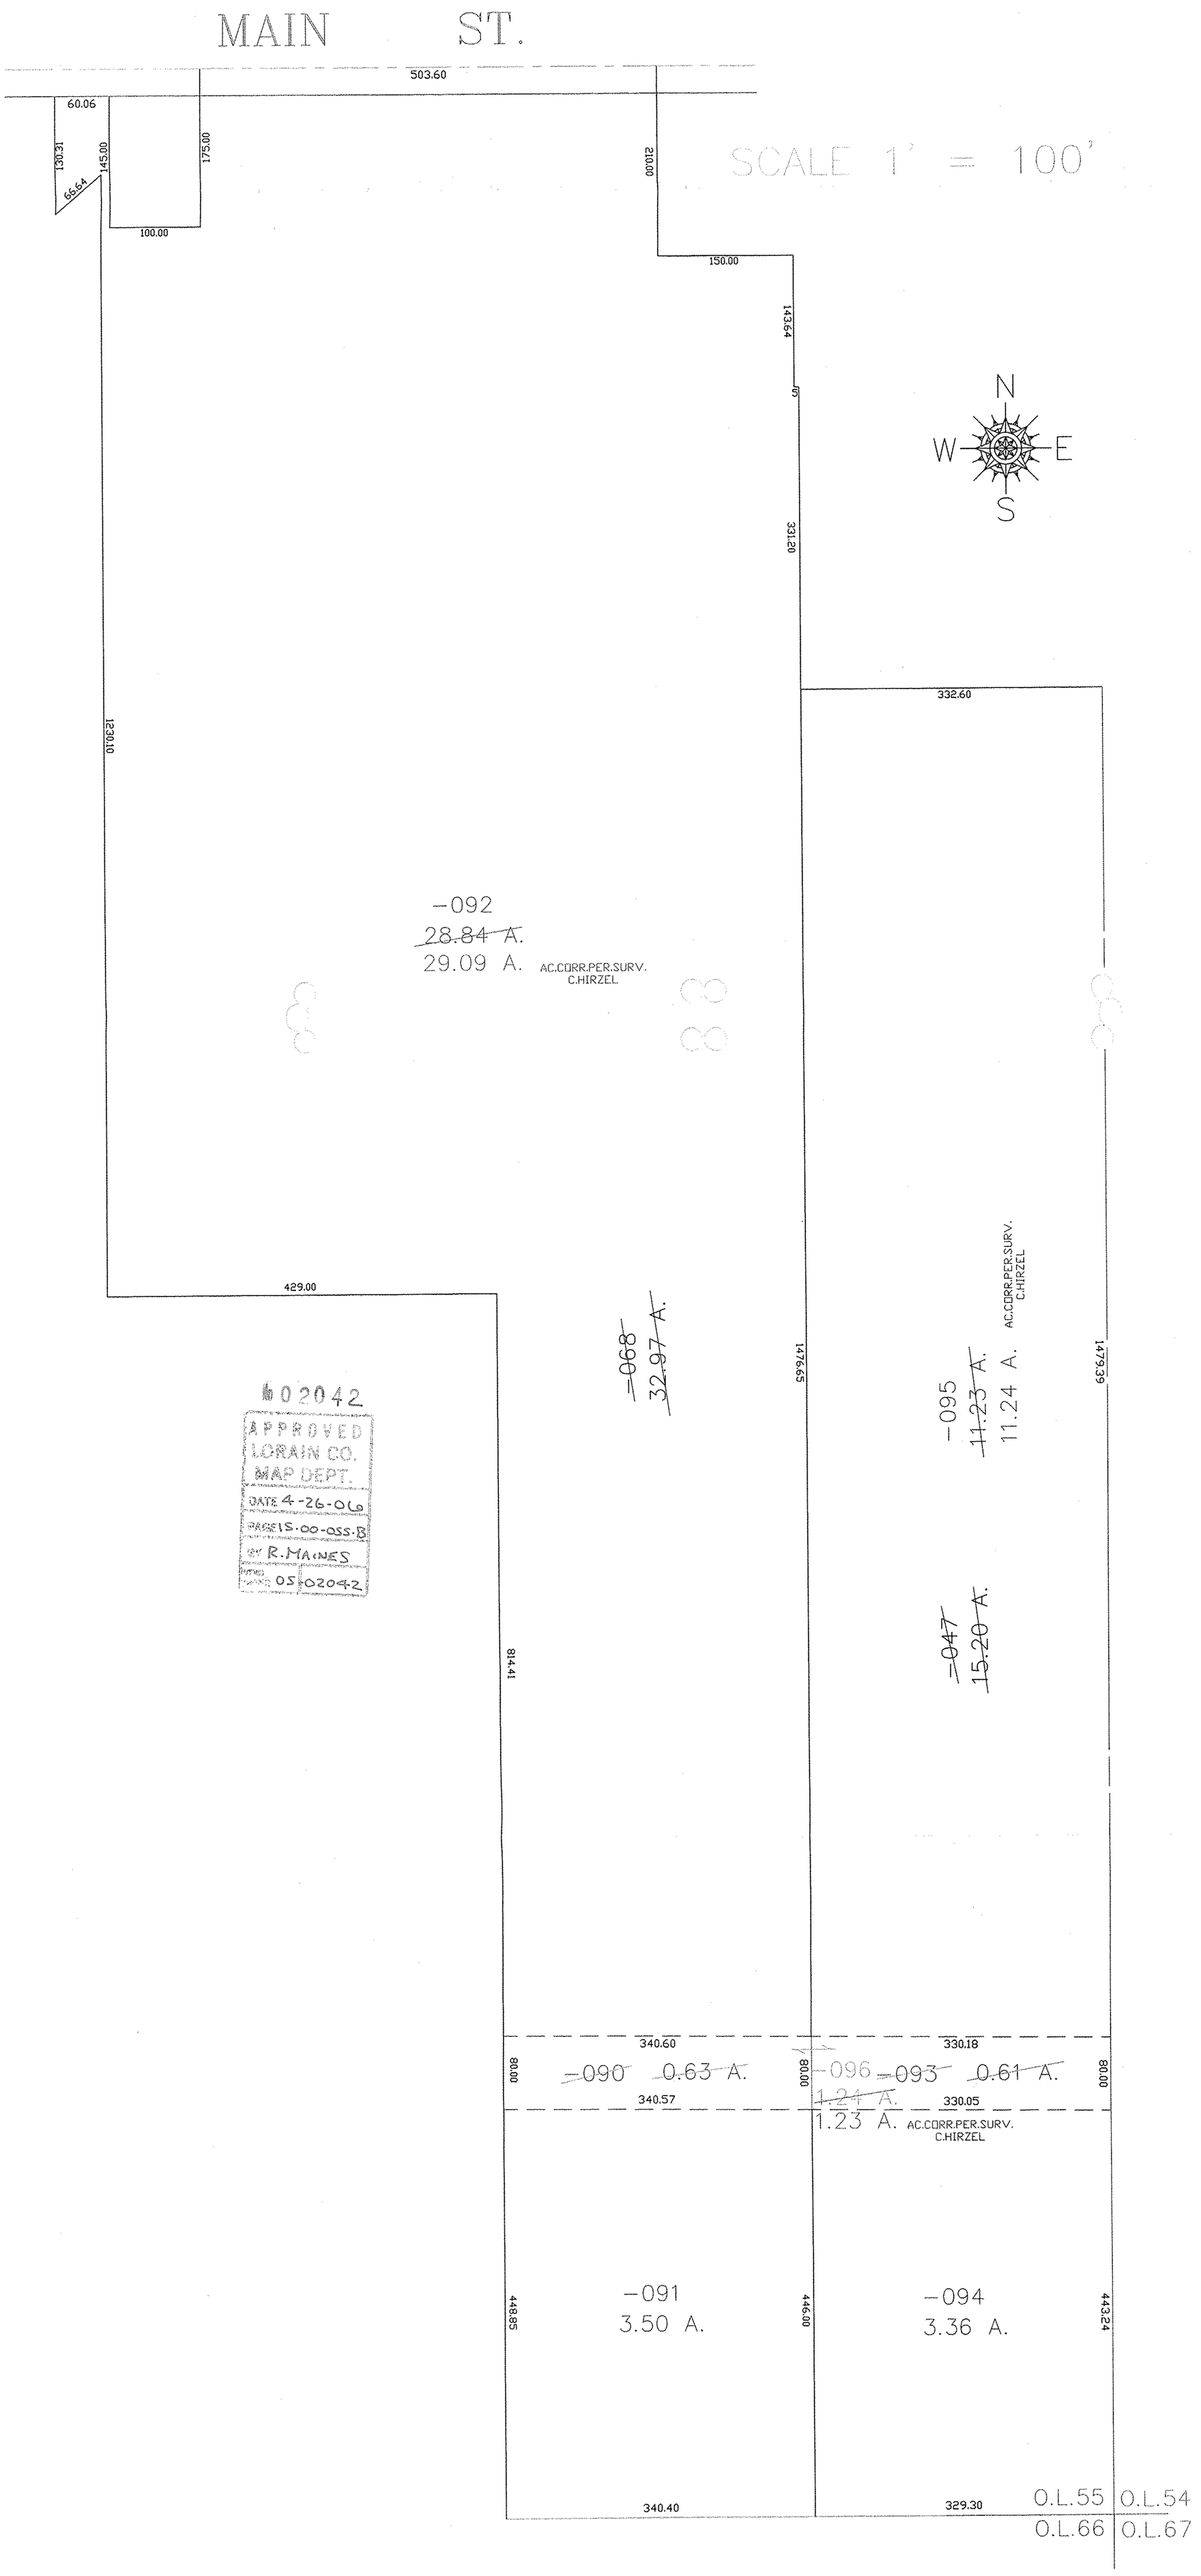

#02042
APPROVED
LORAIN CO.
MAP DEPT.
DATE 4-26-06
PARCELS-00-055-B
BY R.MAINES
MAP NO. 05-02042