


PARENT PARCEL: 09-00-074-101-018, -017

CHILD PARCEL: 09-00-074-101-051 THRU -053

STARTING POINT: CENTERLINE OF PYLE SOUTH AMHERST RD. & O.L. 74

05-02054

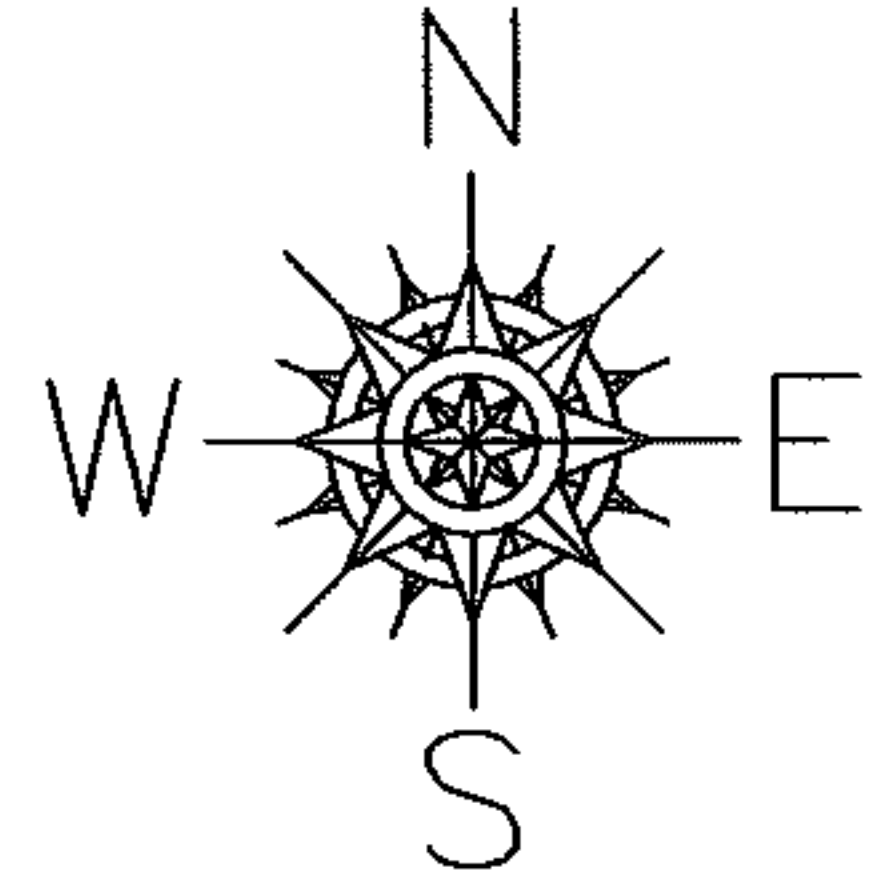

PYLE SOUTH AMHERST RD.

O.L. 64

O.L. 74

847.00

429.00
~~-053~~ ~~-017~~
1.82 A. ~~1.23 A.~~

429.00

~~-051~~ ~~0.59 A.~~

429.00

~~-018~~

~~9.27 A.~~

~~-052~~

~~2.68 A.~~

2.44 A.

A CORR PER SURVEY
THOMAS SNEZEK


429.00

248.00

60

248.00

185.00

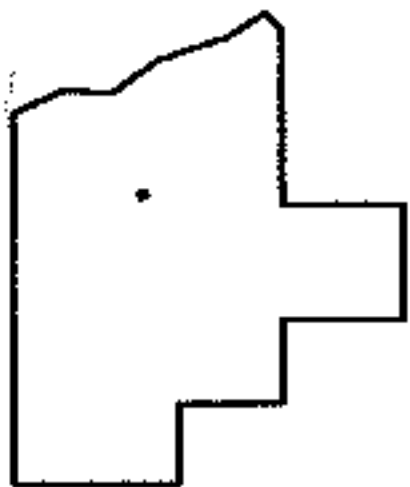

SPLITS/DEEDS PROCESSED

LORAIN COUNTY TAX MAP DEPARTMENT
226 MIDDLE AVE. ELYRIA, OHIO

SURVEYED BY: THOMAS SNEZEK

CLOSURE: 0.00 : 10.000

MAP PAGE(S): 09-00-074-A

APPROVED BY: JAH DATE: 12-7-05

SCALE: 1" = 100 PRIOR INSTRUMENT: OR 716/551