RASTER

PARENT PARCEL: 07-00-021-102-032
CHILD PARCEL: 07-00-021-102-036, -037
STARTING POINT: CENTERLINE OF AVON-BELDEN RD. & CENTER RIDGE RD

05-02065

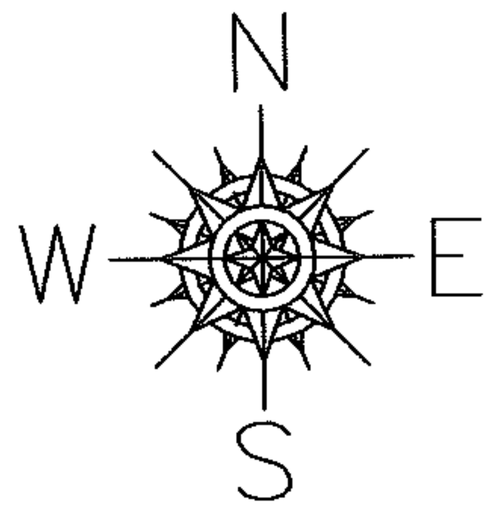

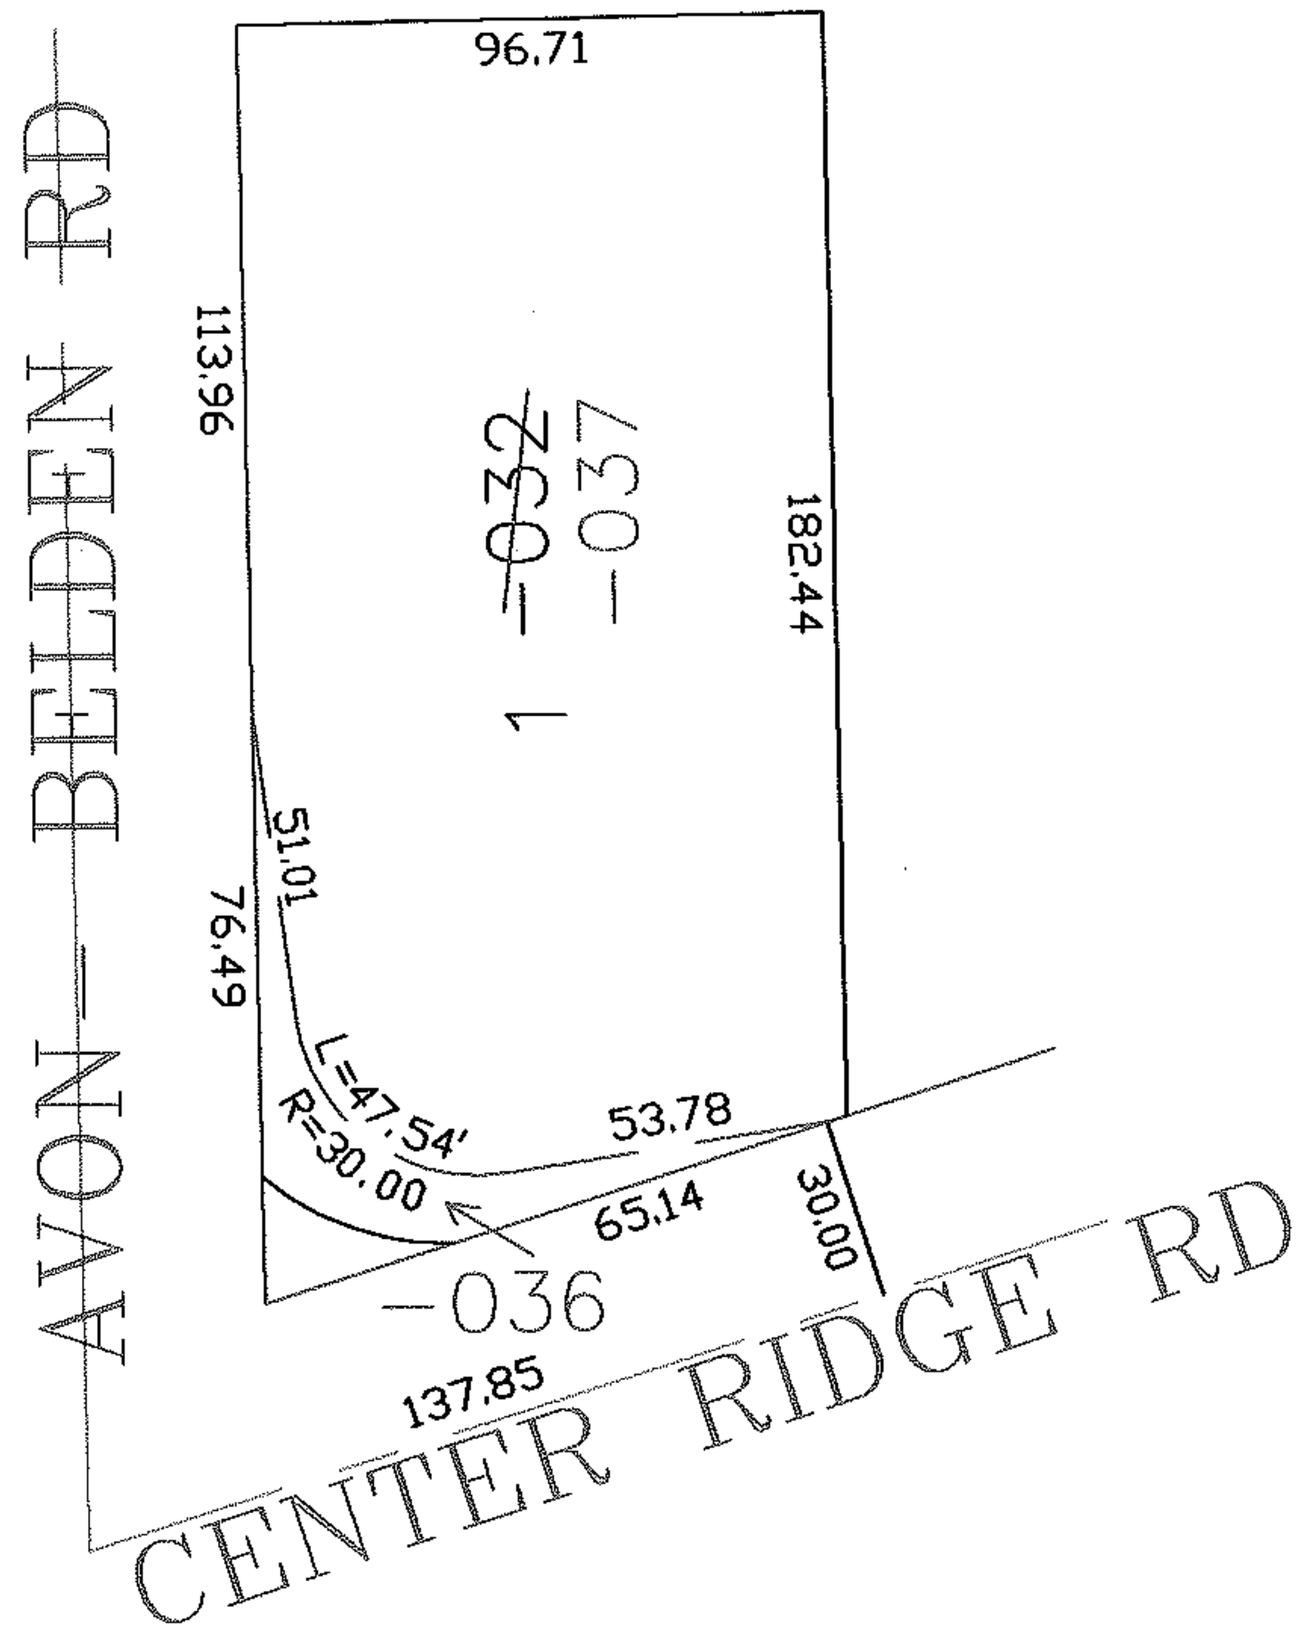

SPLITS/DEEDS PROCESSED

LORAIN COUNTY TAX MAP DEPARTMENT
226 MIDDLE AVE. ELYRIA, OHIO

SURVEYED BY: DONALD HIMES
CLOSURE: 0.00 : 10,000
MAP PAGE(S): 7-00-021-A
APPROVED BY: JAH DATE: 12-21-05
SCALE: 1"= 100 PRIOR INSTRUMENT: PL VL 3/12