RASTER

PARENT PARCEL: 06-24-085-104-038, -039, -040

CHILD PARCEL: XX-XX-XXX-XXX-XXX

STARTING POINT: XXXXXX

10-02084-C

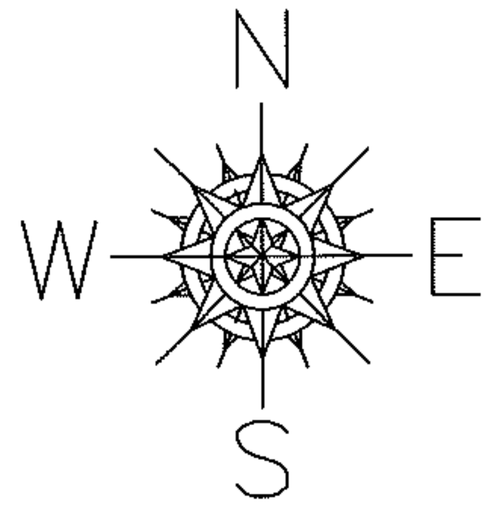

FRONTAGE CORRECTION

06-24-085-104-038

~~0.21 A.~~

45.50 X 175.23

PER DEED 20040983922

06-24-085-104-039

~~46 X 142~~

46.28 X 142

PER DEED 20090315291

06-24-085-104-040

~~45.64 X 143~~

45.50 X 143

PER DEED 19990645729

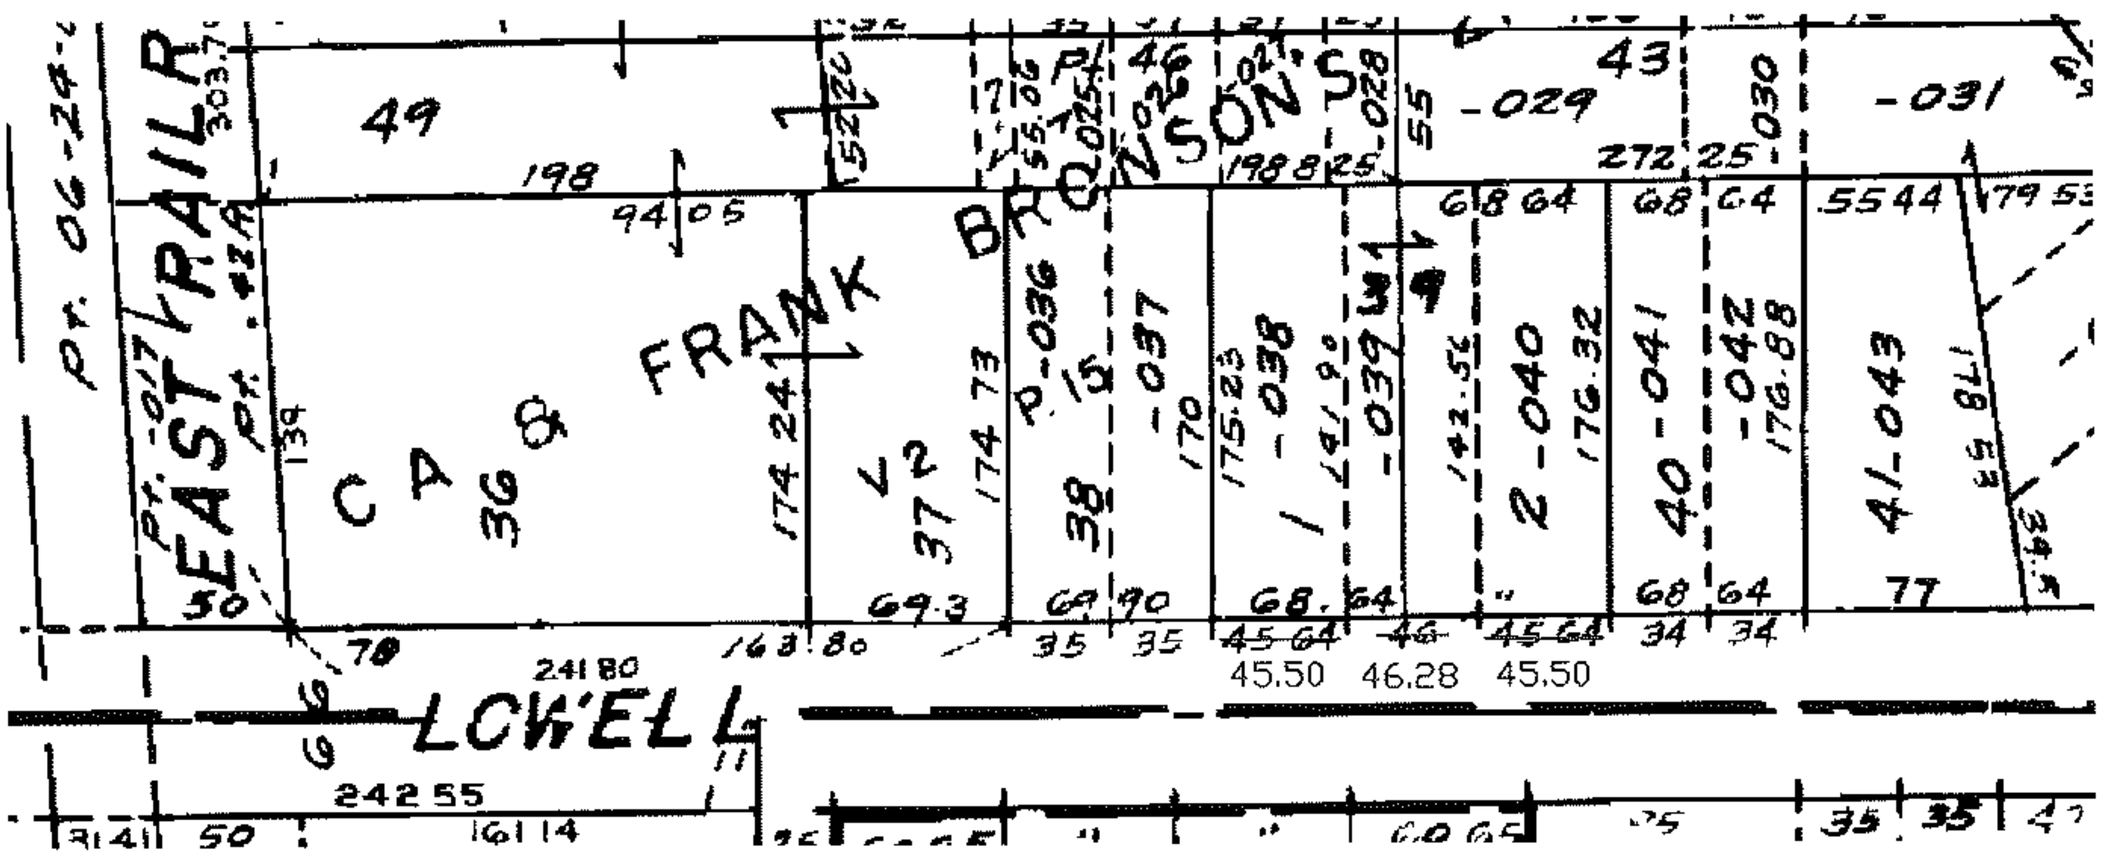

SPLITS/DEEDS PROCESSED

LORAIN COUNTY TAX MAP DEPARTMENT
226 MIDDLE AVE. ELYRIA, OHIO

SURVEYED BY: NONE

CLOSURE: NONE

MAP PAGE(S): 6-99

APPROVED BY: TJS DATE: 9/3/10

SCALE: 1"= 100 PRIOR INST.: DV XXXX/XXX