P.P. NO.	
SPLIT #	DATE OF SURVEY
MAP PAGE	
SURVEYOR	

PLOT 1' = 150'

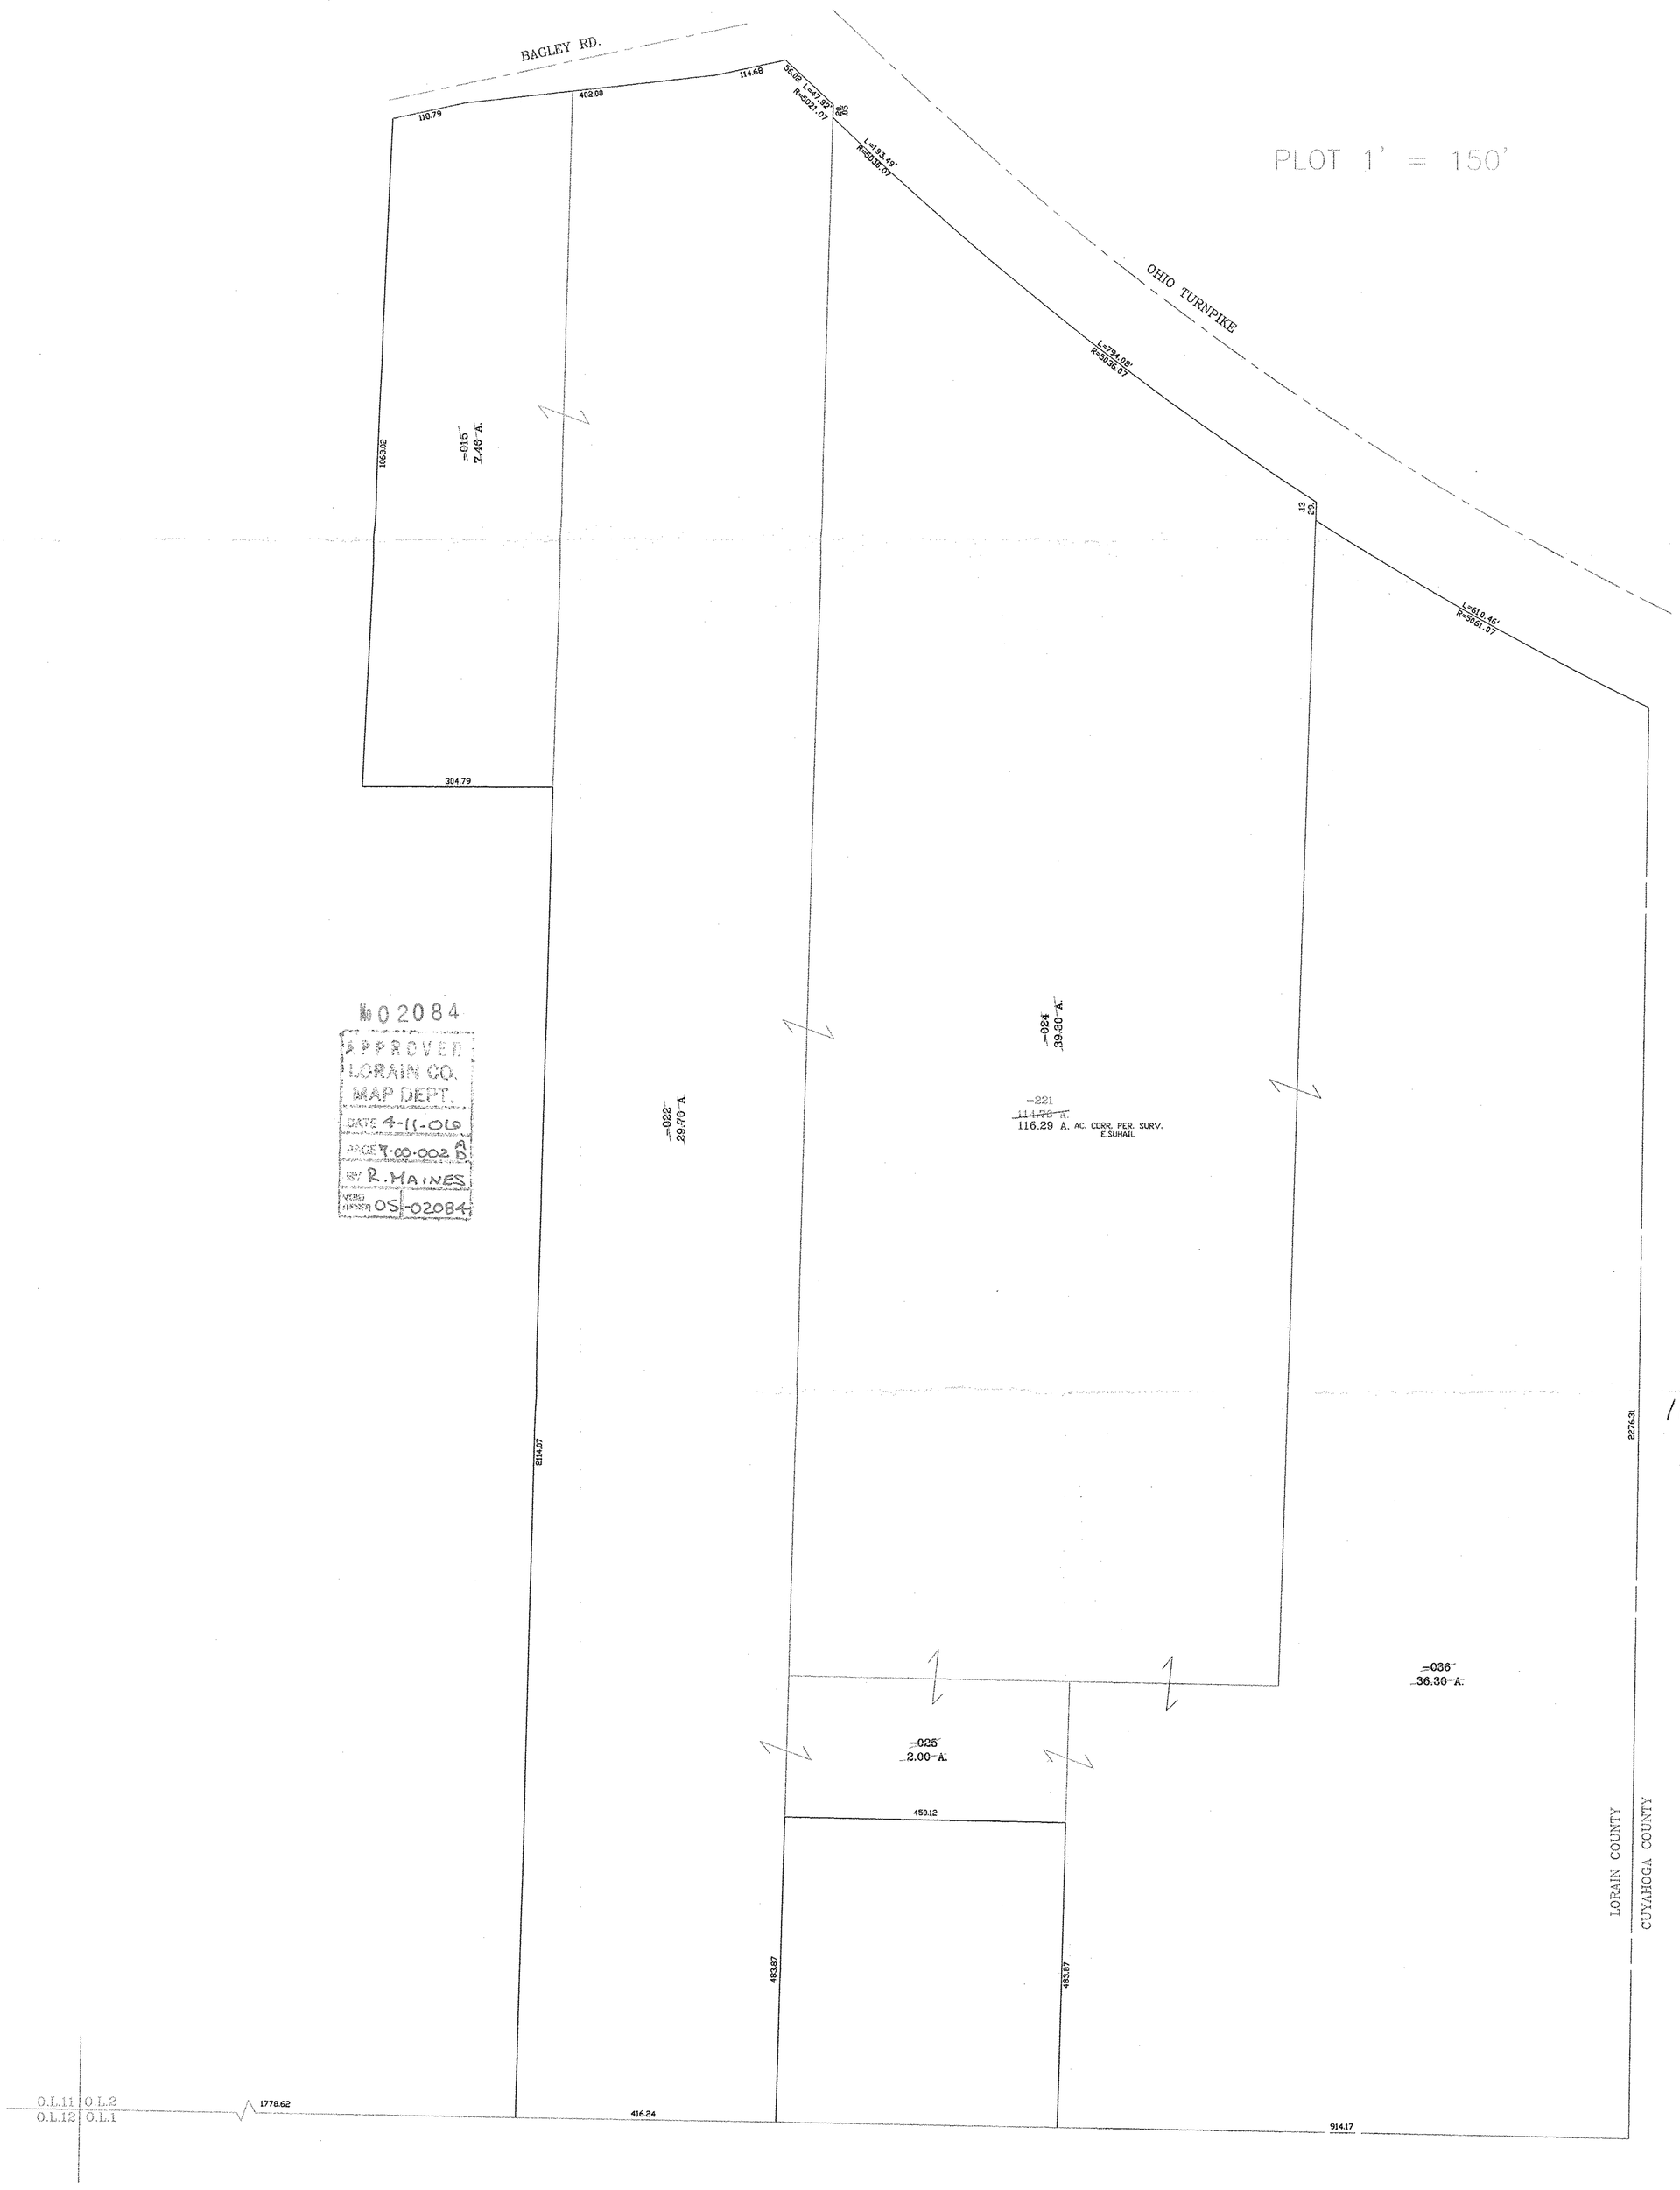

№ 02084
APPROVED
LORAIN CO.
MAP DEPT.
DATE 4-11-06
PAGE 7-00-002 A B
BY R. MAINES
VERIFIED MAPPER 05-02084

10-00-018-102-027

