RASTER

PARENT PARCEL: 04-00-030-114-031
CHILD PARCEL: 04-00-030-114-043 THRU -046
STARTING POINT: CENTERLINE OF ELECTRIC BLVD & HIGHLAND AVE

05-02085

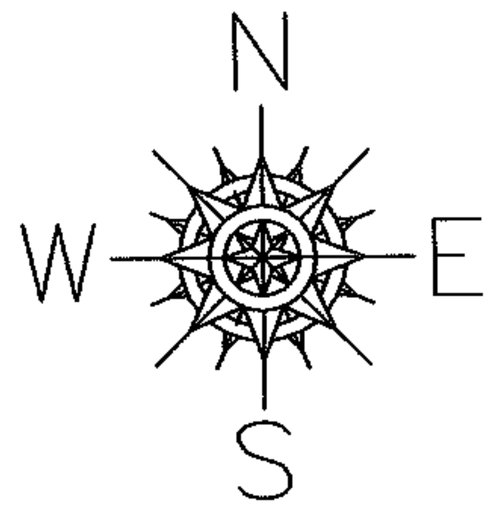

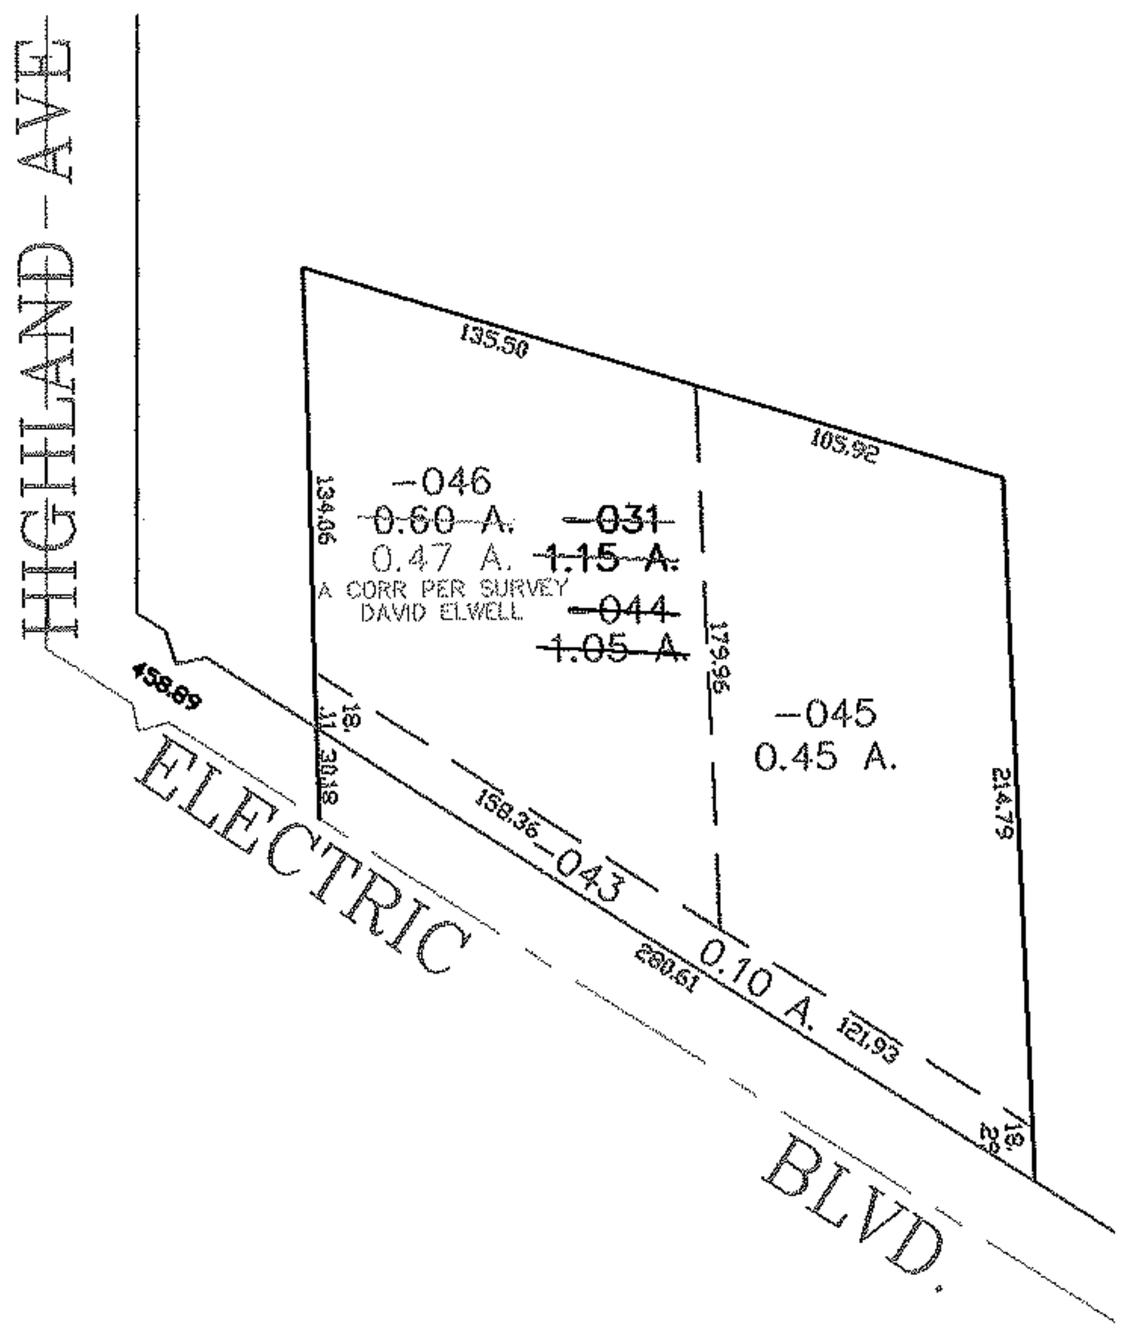

SPLITS/DEEDS PROCESSED

LORAIN COUNTY TAX MAP DEPARTMENT
226 MIDDLE AVE. ELYRIA, OHIO

SURVEYED BY: DAVID ELWELL
CLOSURE: 0.00 : 10,000
MAP PAGE(S): 04-00-030-D
APPROVED BY: JAH DATE: 1-25-06
SCALE: 1"= 100 PRIOR INSTRUMENT: DV 1308/378