


RASTER

PARENT PARCEL: 03-00-106-116-004,-005,-006
CHILD PARCEL: _____
STARTING POINT: S/L'S 23-25 IN CENTRAL DIVISION(VOL.9 PG.5)

10-02090-C

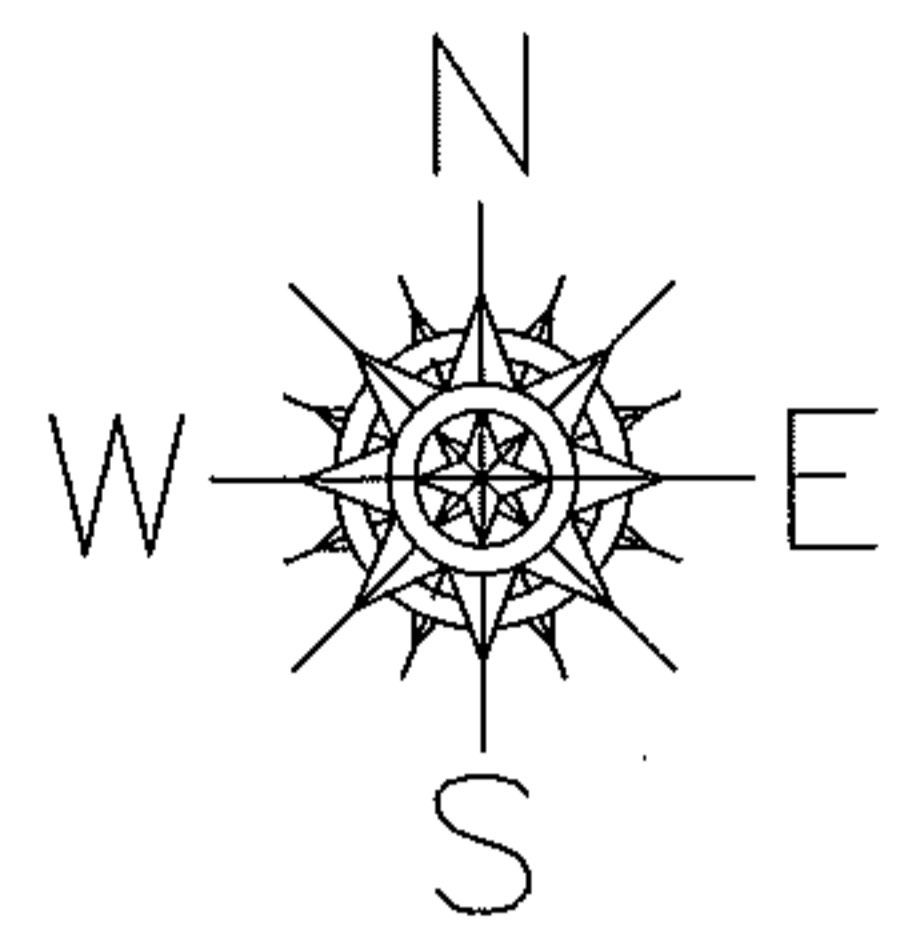


DEPTH CORRECTION

03-00-106-116-004
30 X 127.50
~~30 X 120~~

03-00-106-116-005
30 X 127.50
~~30 X 120~~

03-00-106-116-006
30 X 127.50
~~30 X 120~~

PER PRIOR DEEDS
20070221621
20050081405
AND COURT CASE
NO.10CV168262

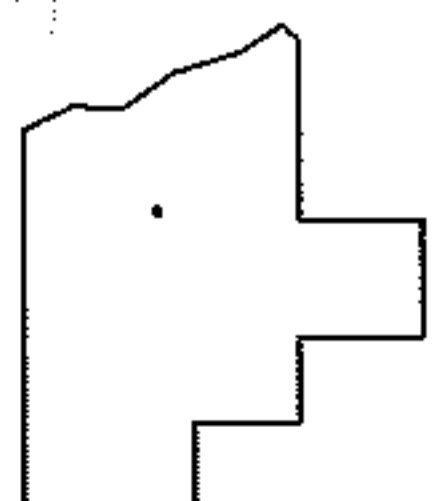

SPLITS/DEEDS PROCESSED

LORAIN COUNTY TAX MAP DEPARTMENT
226 MIDDLE AVE. ELYRIA, OHIO

SURVEYED BY: N/A
CLOSURE: N/A
MAP PAGE(S): 3-00-106-B
APPROVED BY: RRM DATE: 9-9-10
SCALE: 1"= 50' PRIOR INST.: SEE ABOVE