PARENT PARCEL: 05-00-013-101-021, -020 05-00-008-000-008

CHILD PARCEL: 05-00-013-101-025 THRU -027 05-00-008-000-012 THRU -014

STARTING POINT: CENTERLINE OF PYLE- SOUTH AMHERST RD & O.L. 8

06-02093

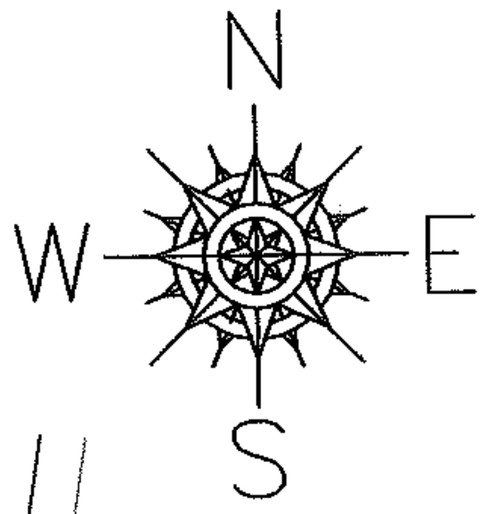

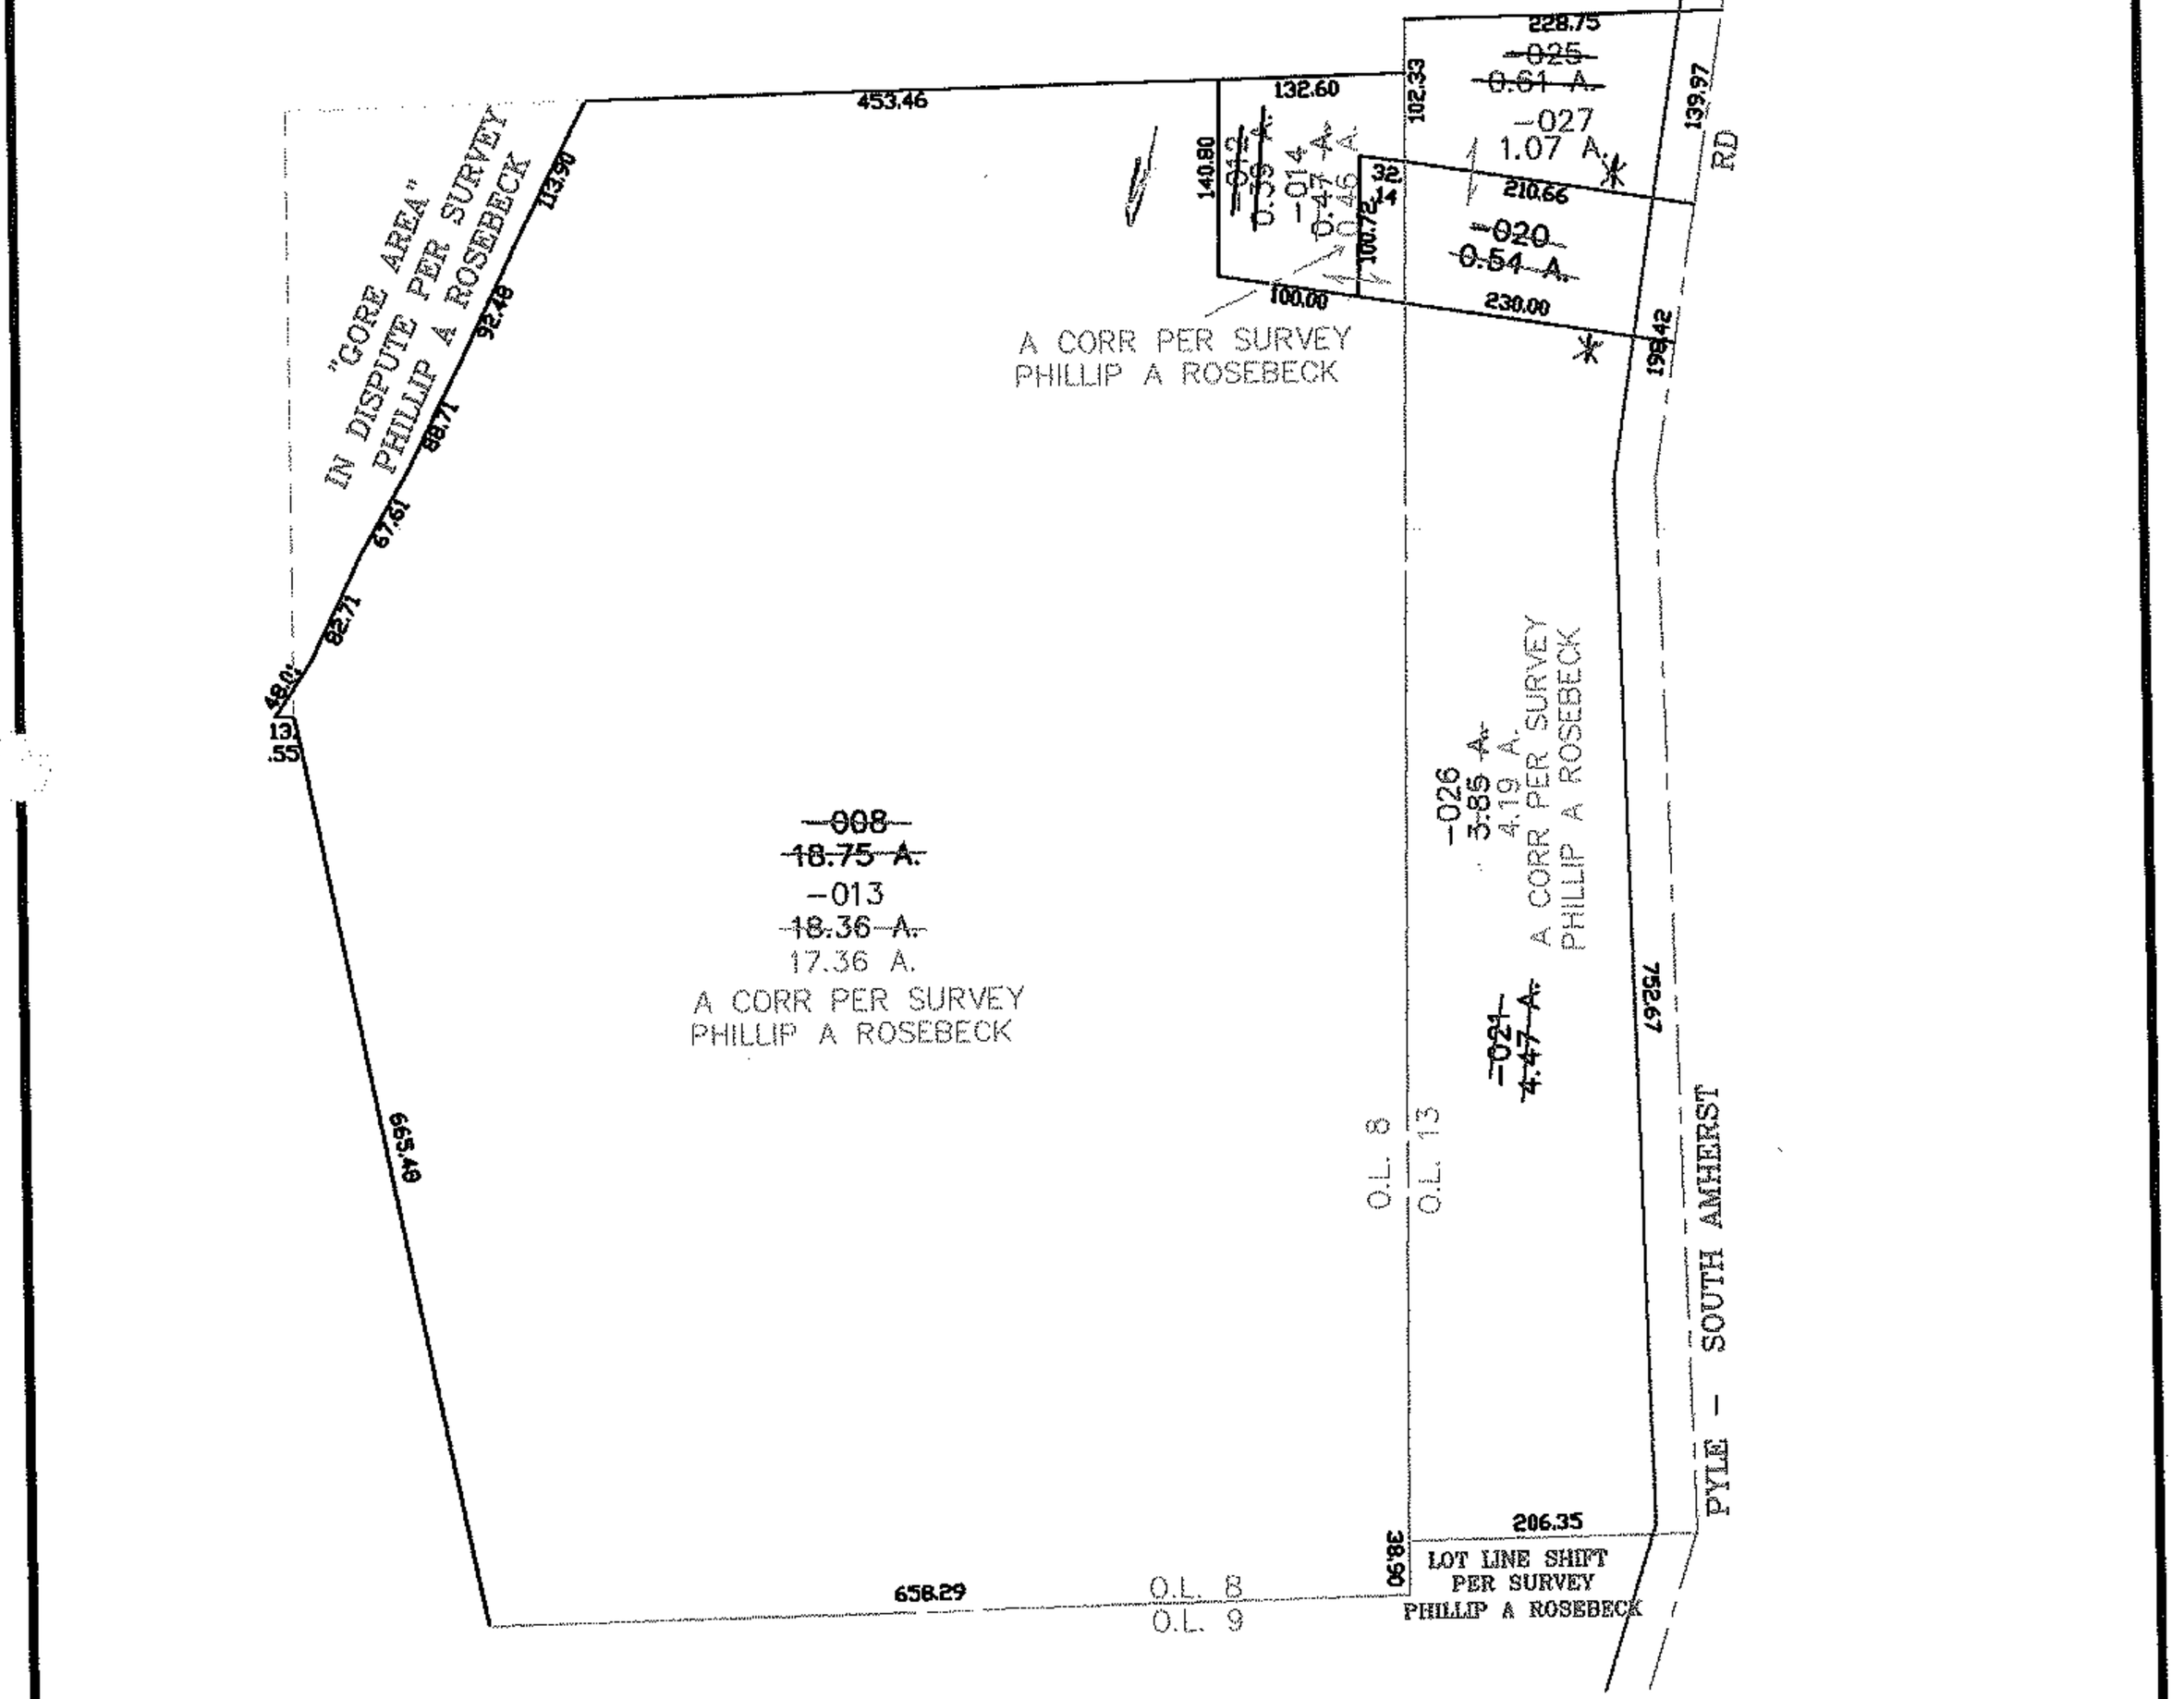

SPLITS/DEEDS PROCESSED

LORAIN COUNTY TAX MAP DEPARTMENT
226 MIDDLE AVE. ELYRIA, OHIO

SURVEYED BY: PHILLIP A ROSEBECK

CLOSURE: 0.00 : 10,000

MAP PAGE(S): 05-00-013-A

APPROVED BY: JAH DATE: 2-2-06

SCALE: 1"= 200 PRIOR INSTRUMENT: DV 1024/231