RASTER

PARENT PARCEL: 07-00-024-102-051 07-00-013-000-212
CHILD PARCEL: 07-00-024-102-058, -059 07-00-013-000-254, -255
STARTING POINT: CENTERLINE OF LORAIN RD & STONEBRIAR LN

06-02096

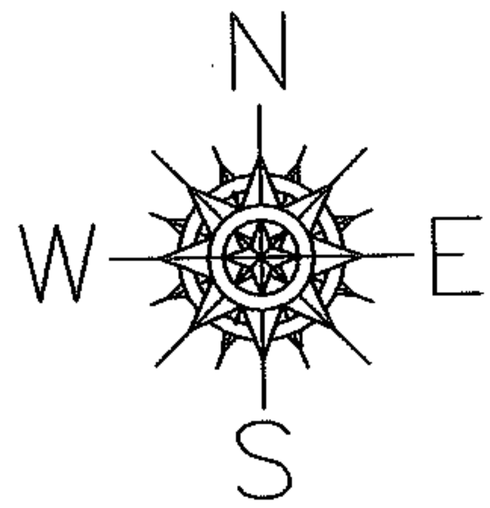

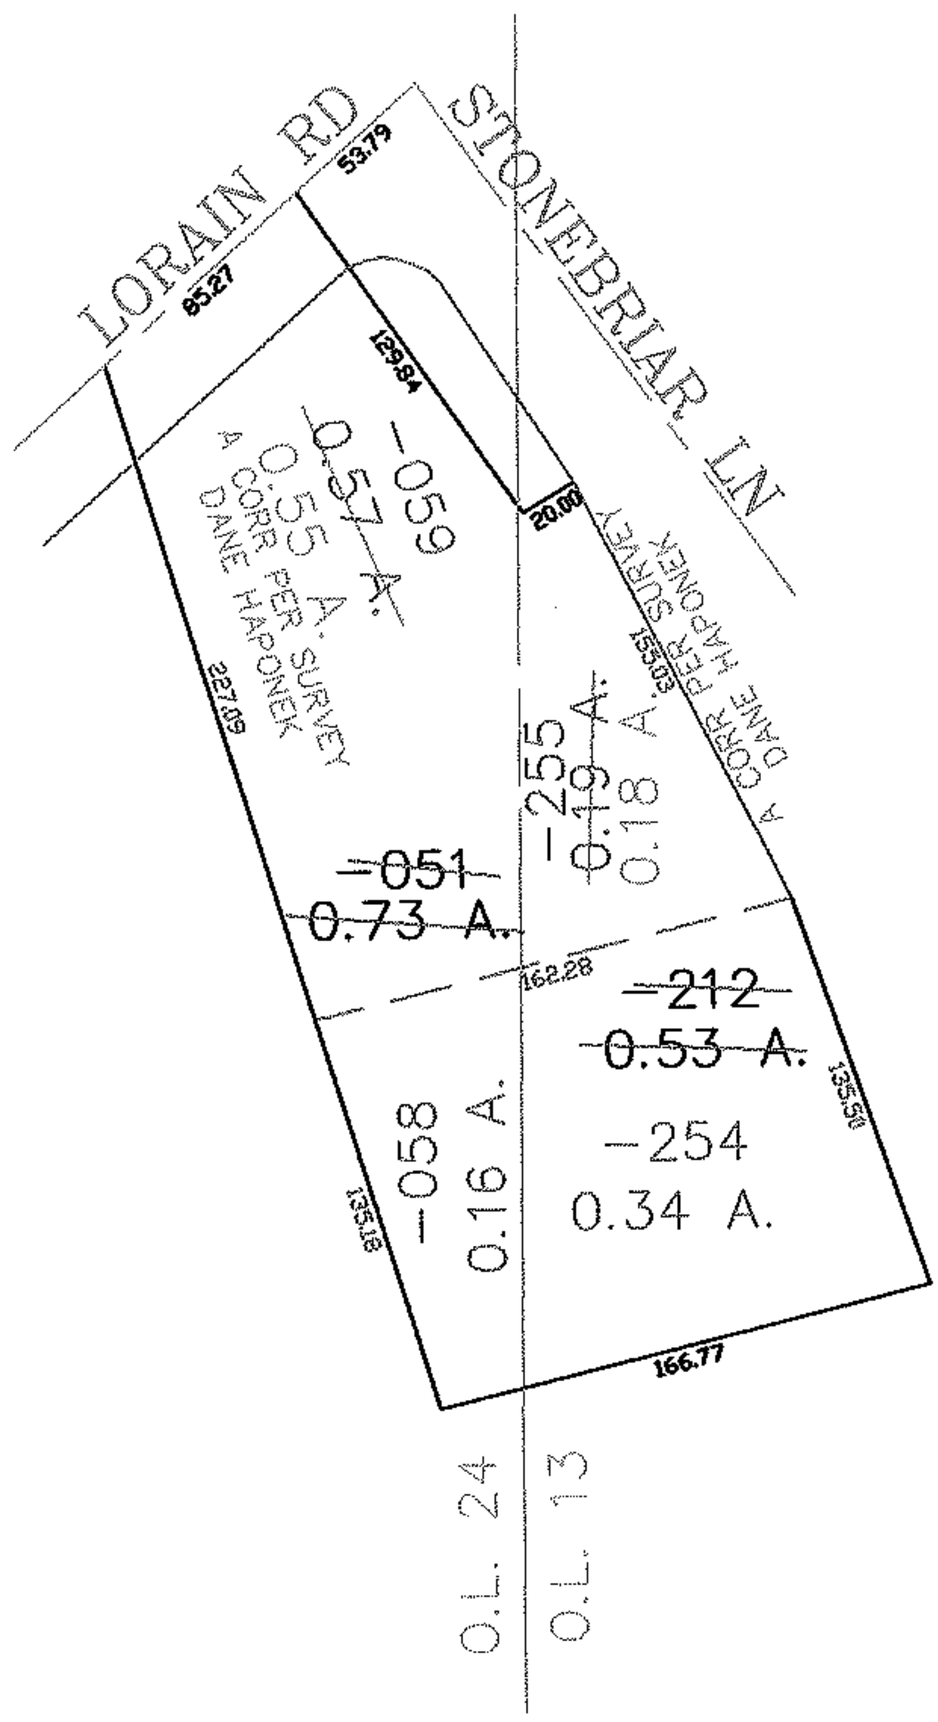

SPLITS/DEEDS PROCESSED

LORAIN COUNTY TAX MAP DEPARTMENT
226 MIDDLE AVE. ELYRIA, OHIO

SURVEYED BY: DANE HAPONEK
CLOSURE: 0.00 : 10,000
MAP PAGE(S): 07-00-024-B
APPROVED BY: JAH DATE: 2-9-06
SCALE: 1"= 100 PRIOR INSTRUMENT: 20040985133