PLOT 1" = 200'

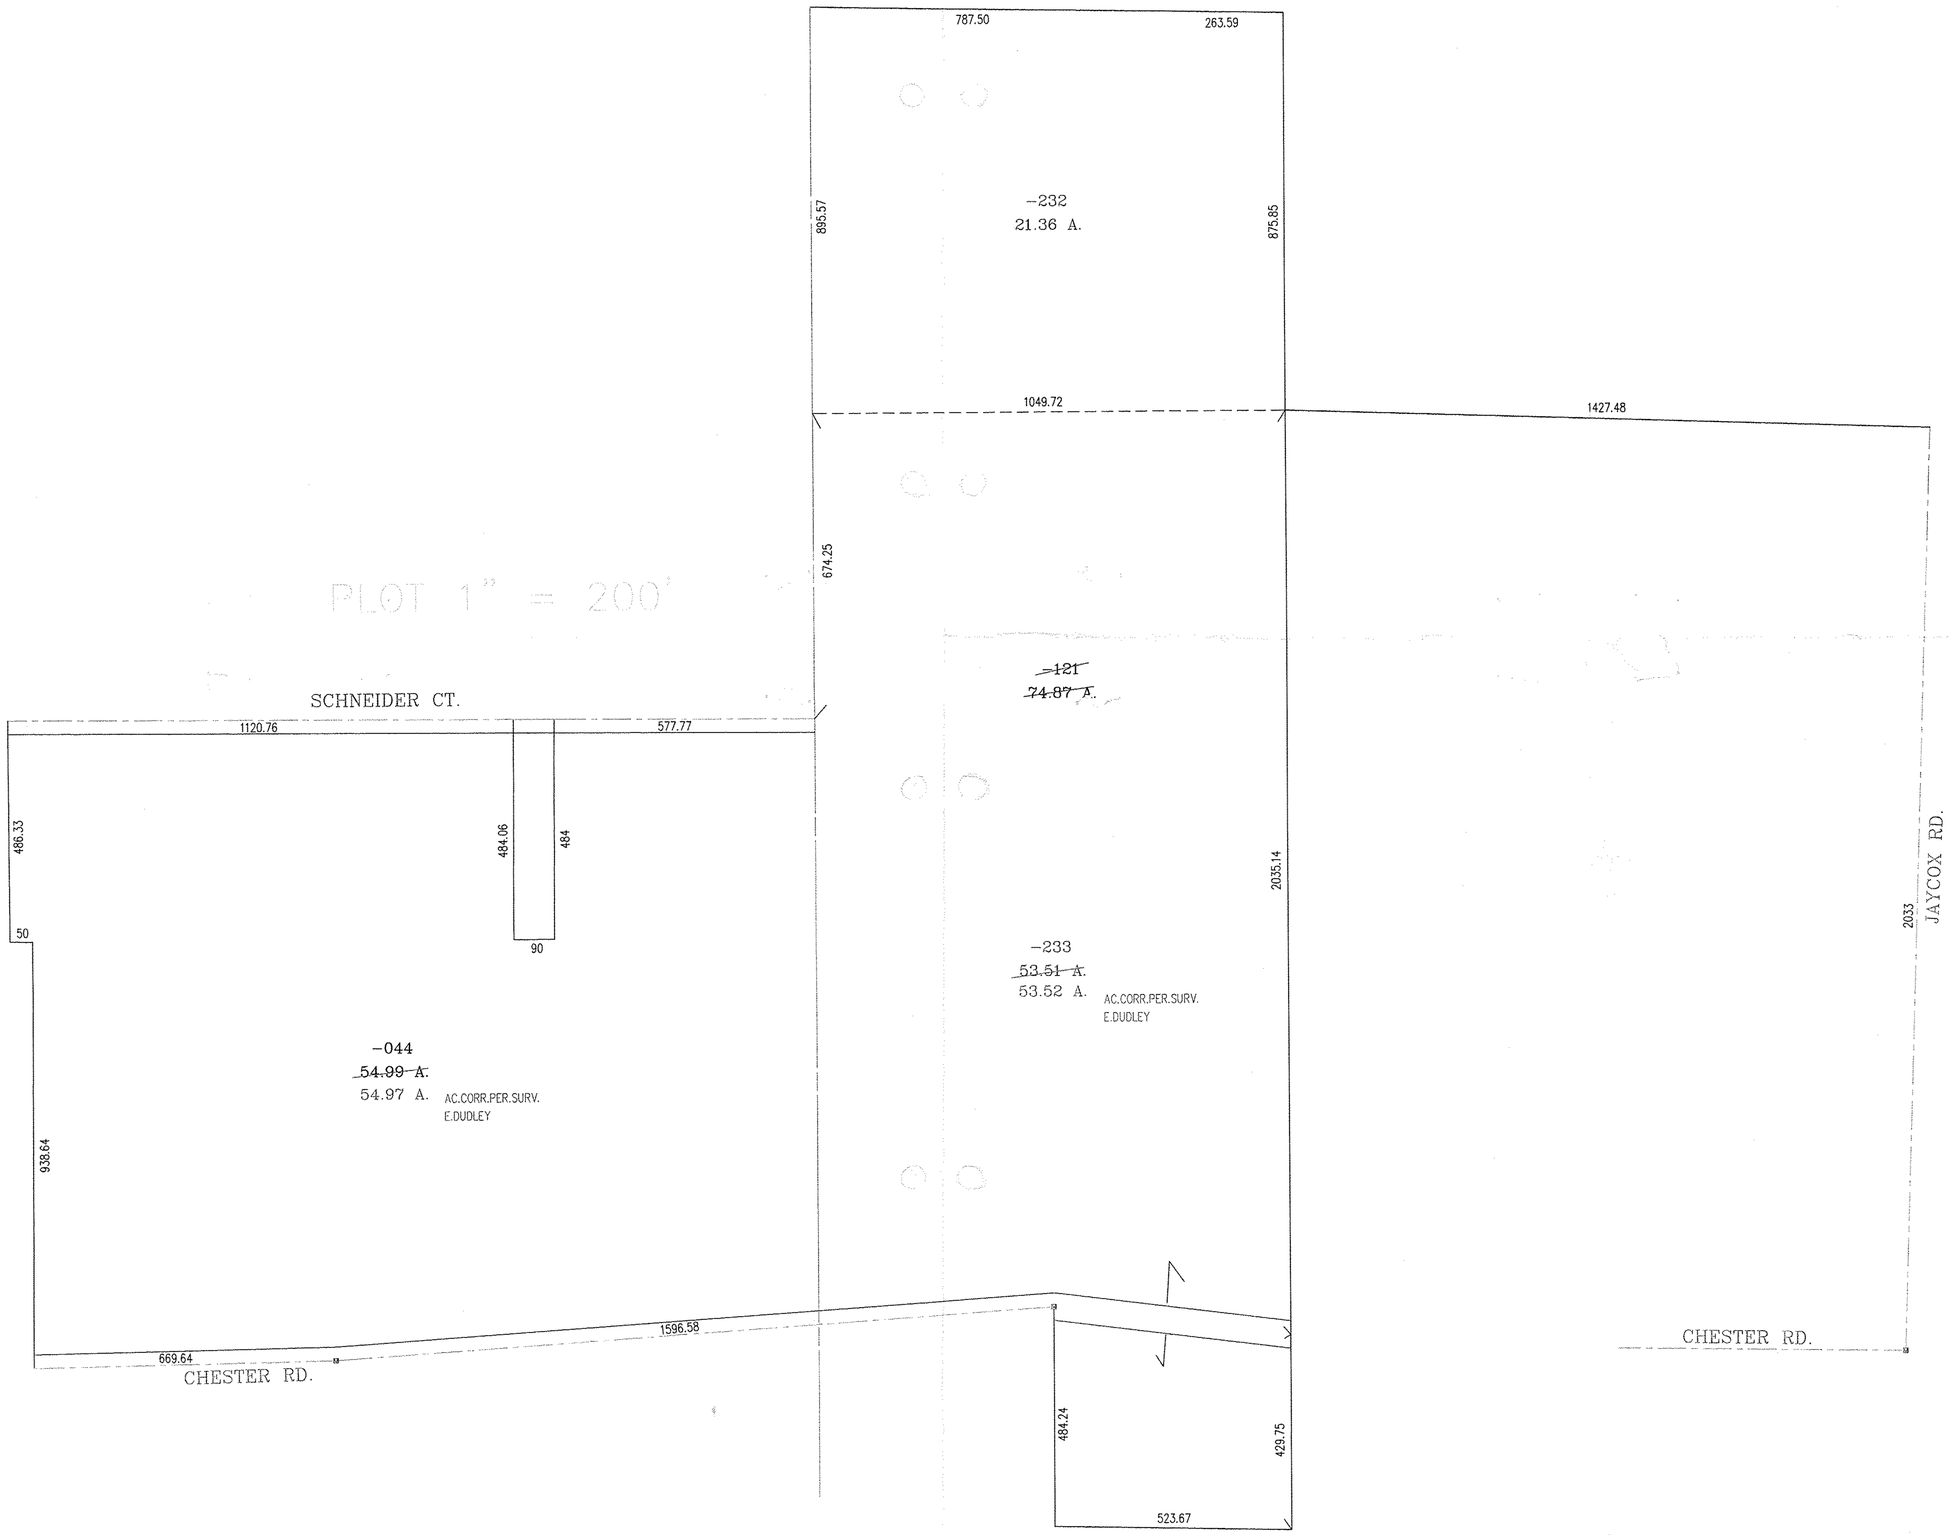

02100

APPROVED
LORAIN CO.
MAP DEPT.
DATE 2-2-06
ZONE 4.00.016.E
4.00.021.E
BY R.MAINES
06P2100

00120-70