PARENT PARCEL: 05-00-054-000-036, 05-00-067-000-001
CHILD PARCEL: 05-00-054-000-047, -048, 05-00-067-000-004
STARTING POINT: NE CORNER OF O.L. 67

06-02111

AC. CORR.
PER SURVEY
THOMAS SIMON

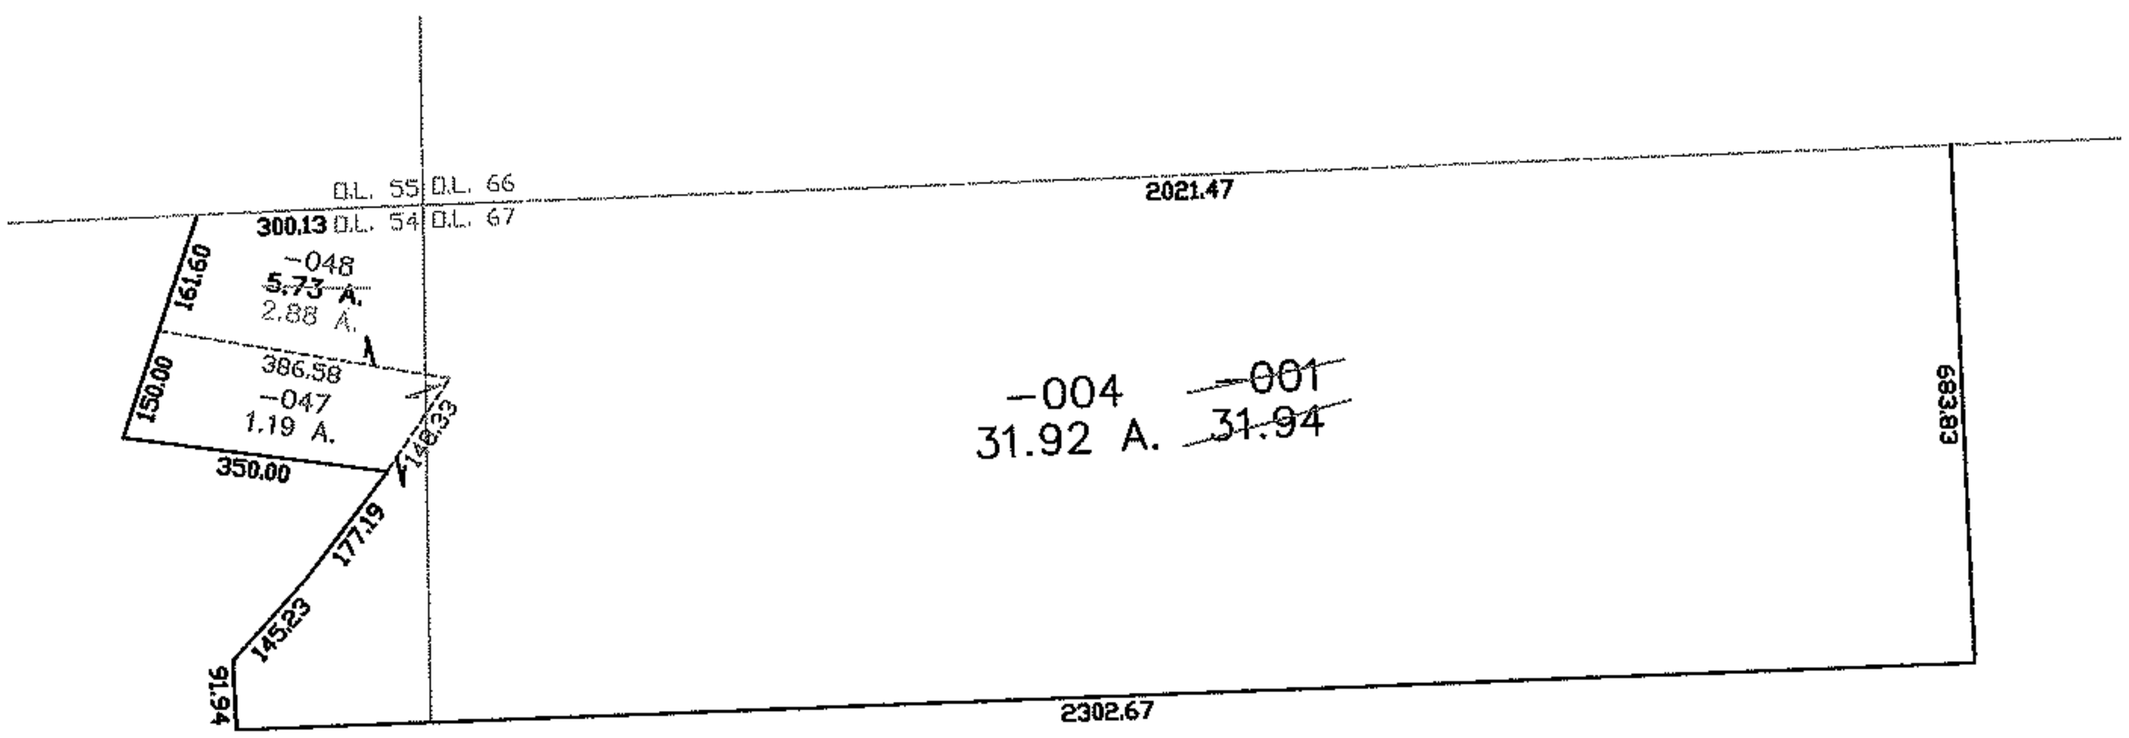

SPLITS/DEEDS PROCESSED
LORAIN COUNTY TAX MAP DEPARTMENT
226 MIDDLE AVE. ELYRIA, OHIO

SURVEYED BY: THOMAS A. SIMON
CLOSURE: 1:10,000
MAP PAGE(S): 05-00-054-B
APPROVED BY: DRH DATE: 2/16/2006
SCALE: 1"= 400 PRIOR INSTRUMENT: OR 601/842