PARENT PARCEL: 15-00-092-000-010 THRU -012, 15-00-093-000-027 THRU -029

CHILD PARCEL:

STARTING POINT: INTERSECTION OF NORTH LINE OF O.L.93 AND C/L OF INDIAN HOLLOW RD.

10-02120-C

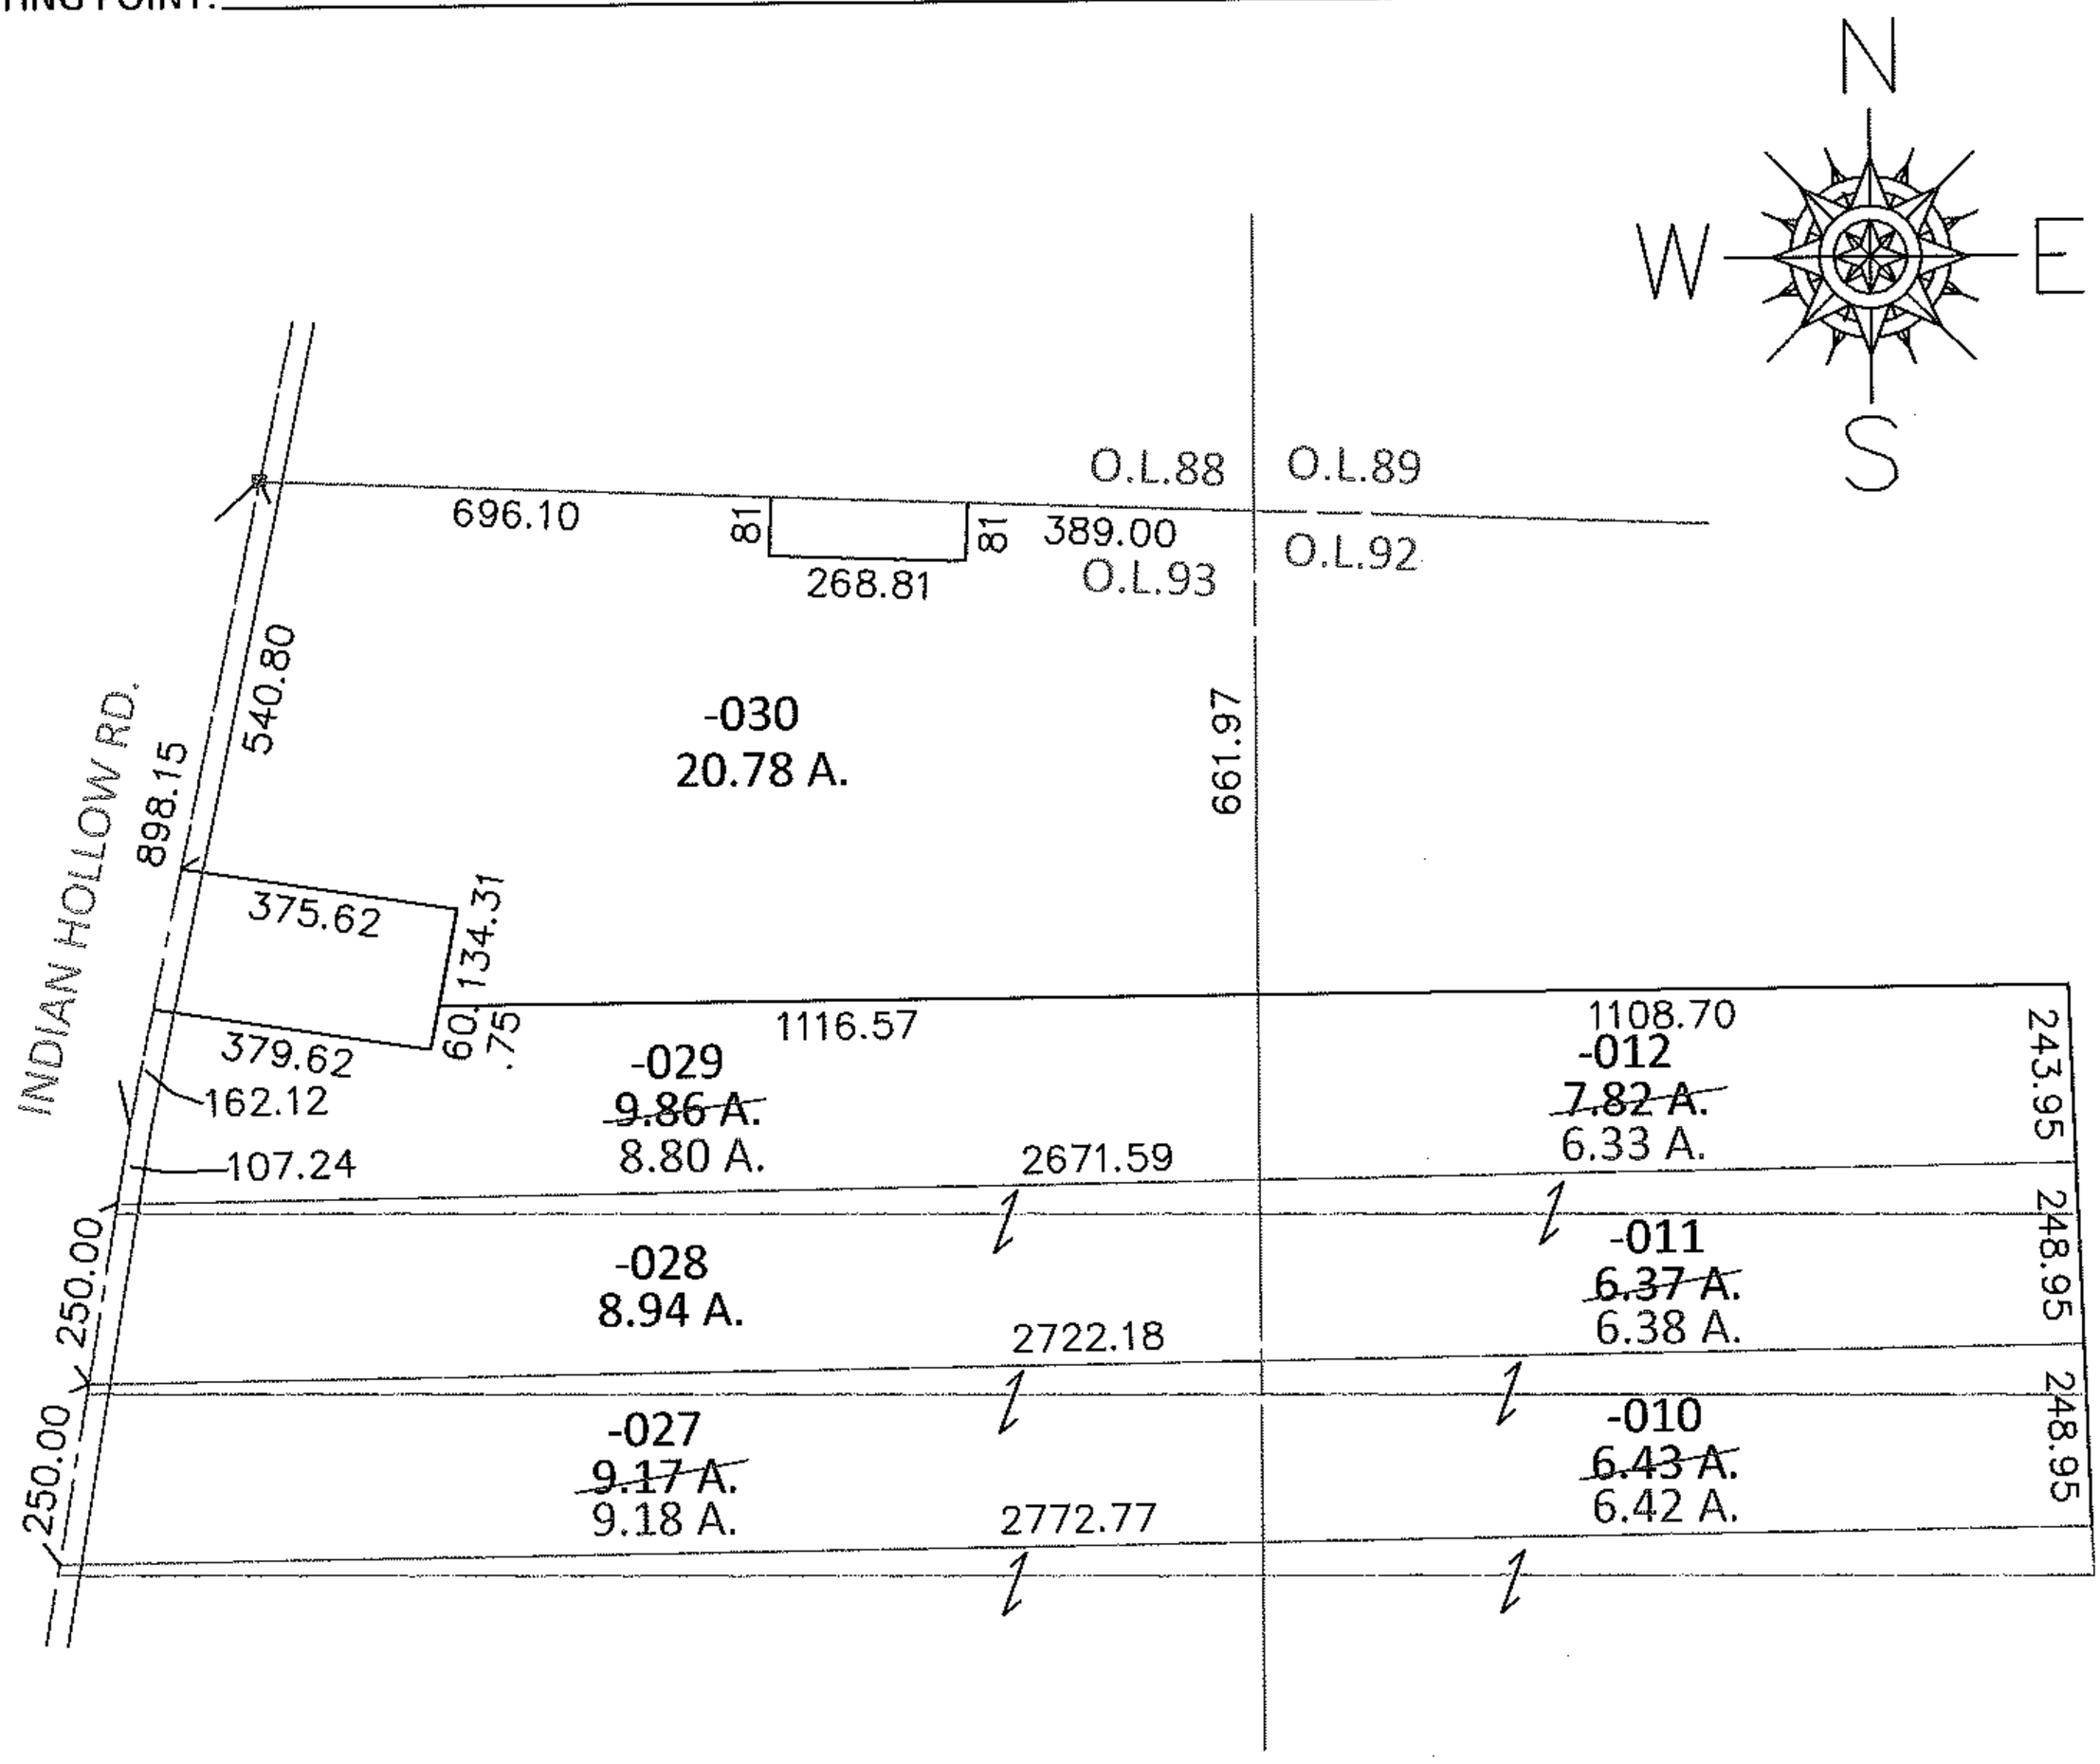

BOUNDARY LINE CORRECTION

BY SURVEY DALE HAYWOOD

CORRECTING TICKET #09-02669

SPLITS/DEEDS PROCESSED

LORAIN COUNTY TAX MAP DEPARTMENT

226 MIDDLE AVE. ELYRIA, OHIO

SURVEYED BY: DALE R. HAYWOOD

CLOSURE: .01:10,000

MAP PAGE(S): 15-H

APPROVED BY: RRM DATE: 10/27/10

SCALE: 1"= 400 PRIOR INST.: 20080269744