RASTER

PARENT PARCEL: 04-00-005-000-100, -099

CHILD PARCEL: 04-00-005-000-111 THRU -116

STARTING POINT: XXXXXX

06-02139

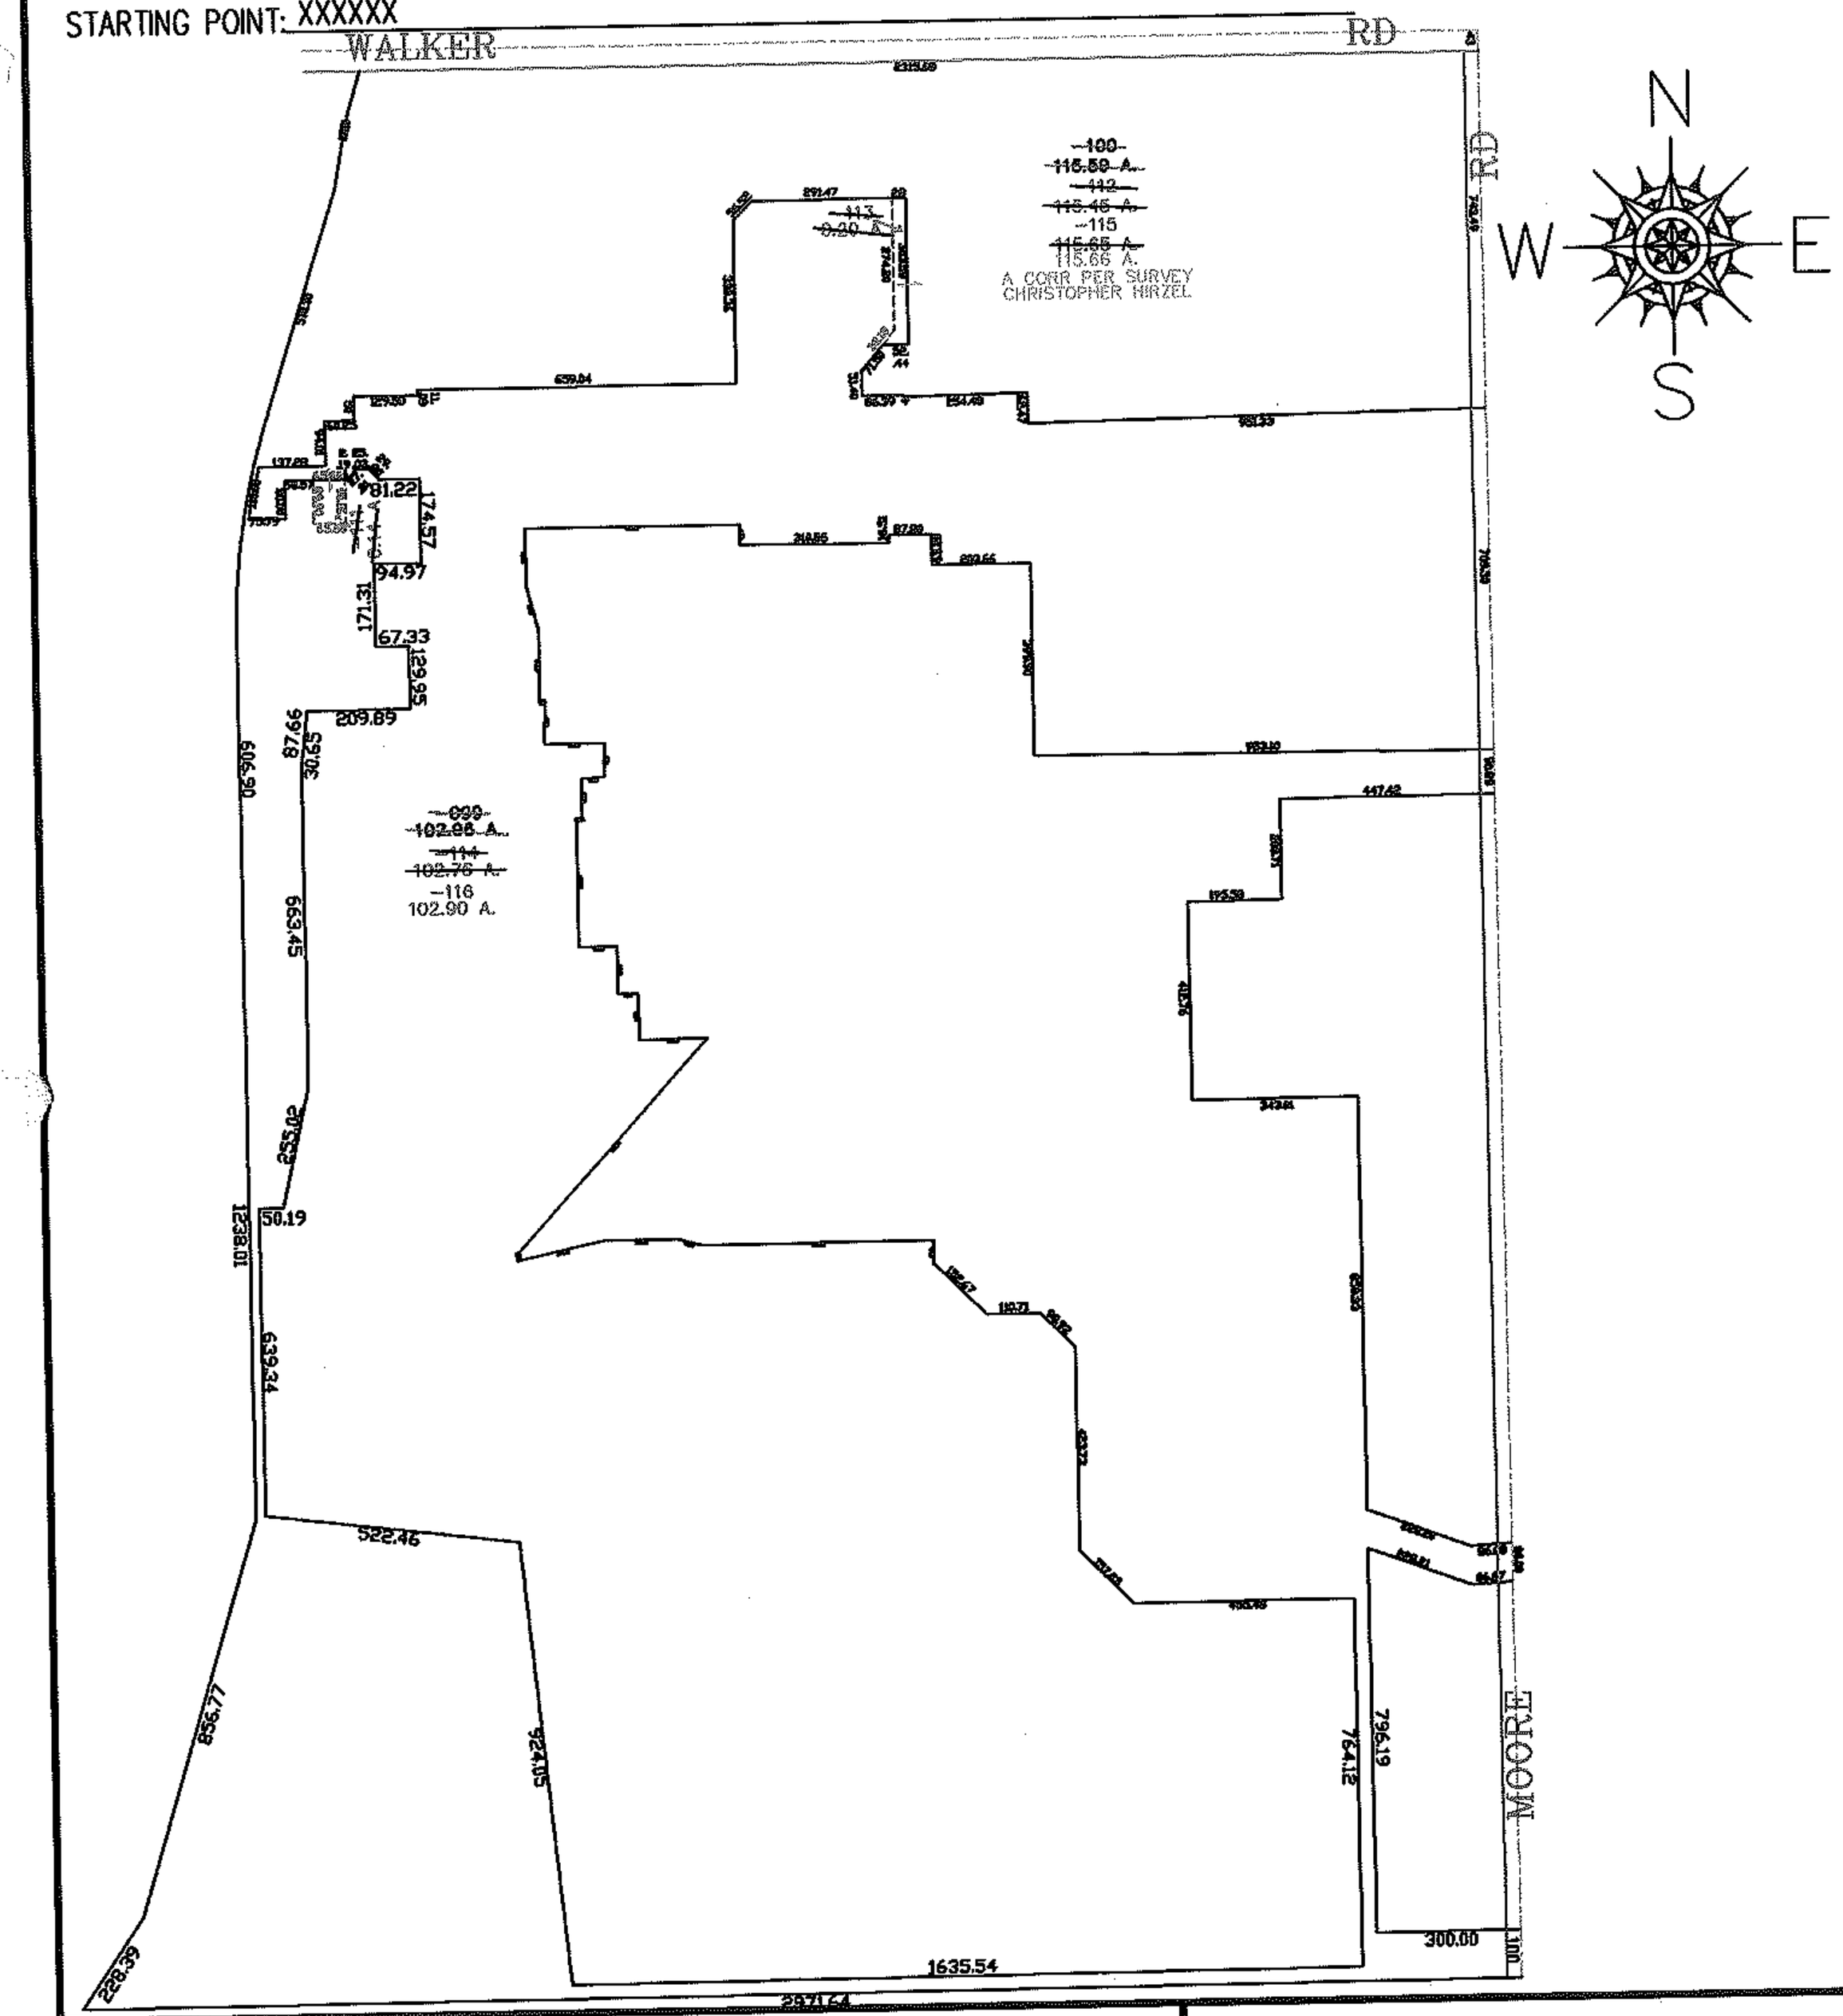

SPLITS/DEEDS PROCESSED

LORAIN COUNTY TAX MAP DEPARTMENT
226 MIDDLE AVE. ELYRIA, OHIO

SURVEYED BY: CHRISTOPHER HIRZEL

CLOSURE: 0.01 : 10,000

MAP PAGE(S): 04-00-005-C, D, H

APPROVED BY: JAH DATE: 5-02-06

SCALE: 1"= 500 PRIOR INSTRUMENT: 20010738850