RASTER

PARENT PARCEL: 07-00-006-102-188 & -158

CHILD PARCEL: 07-00-006-102-197 THRU -200

STARTING POINT: CENTERLINE OF STRADFORD CT IN WOODS OF STRADFORD SUBD.

06-02140

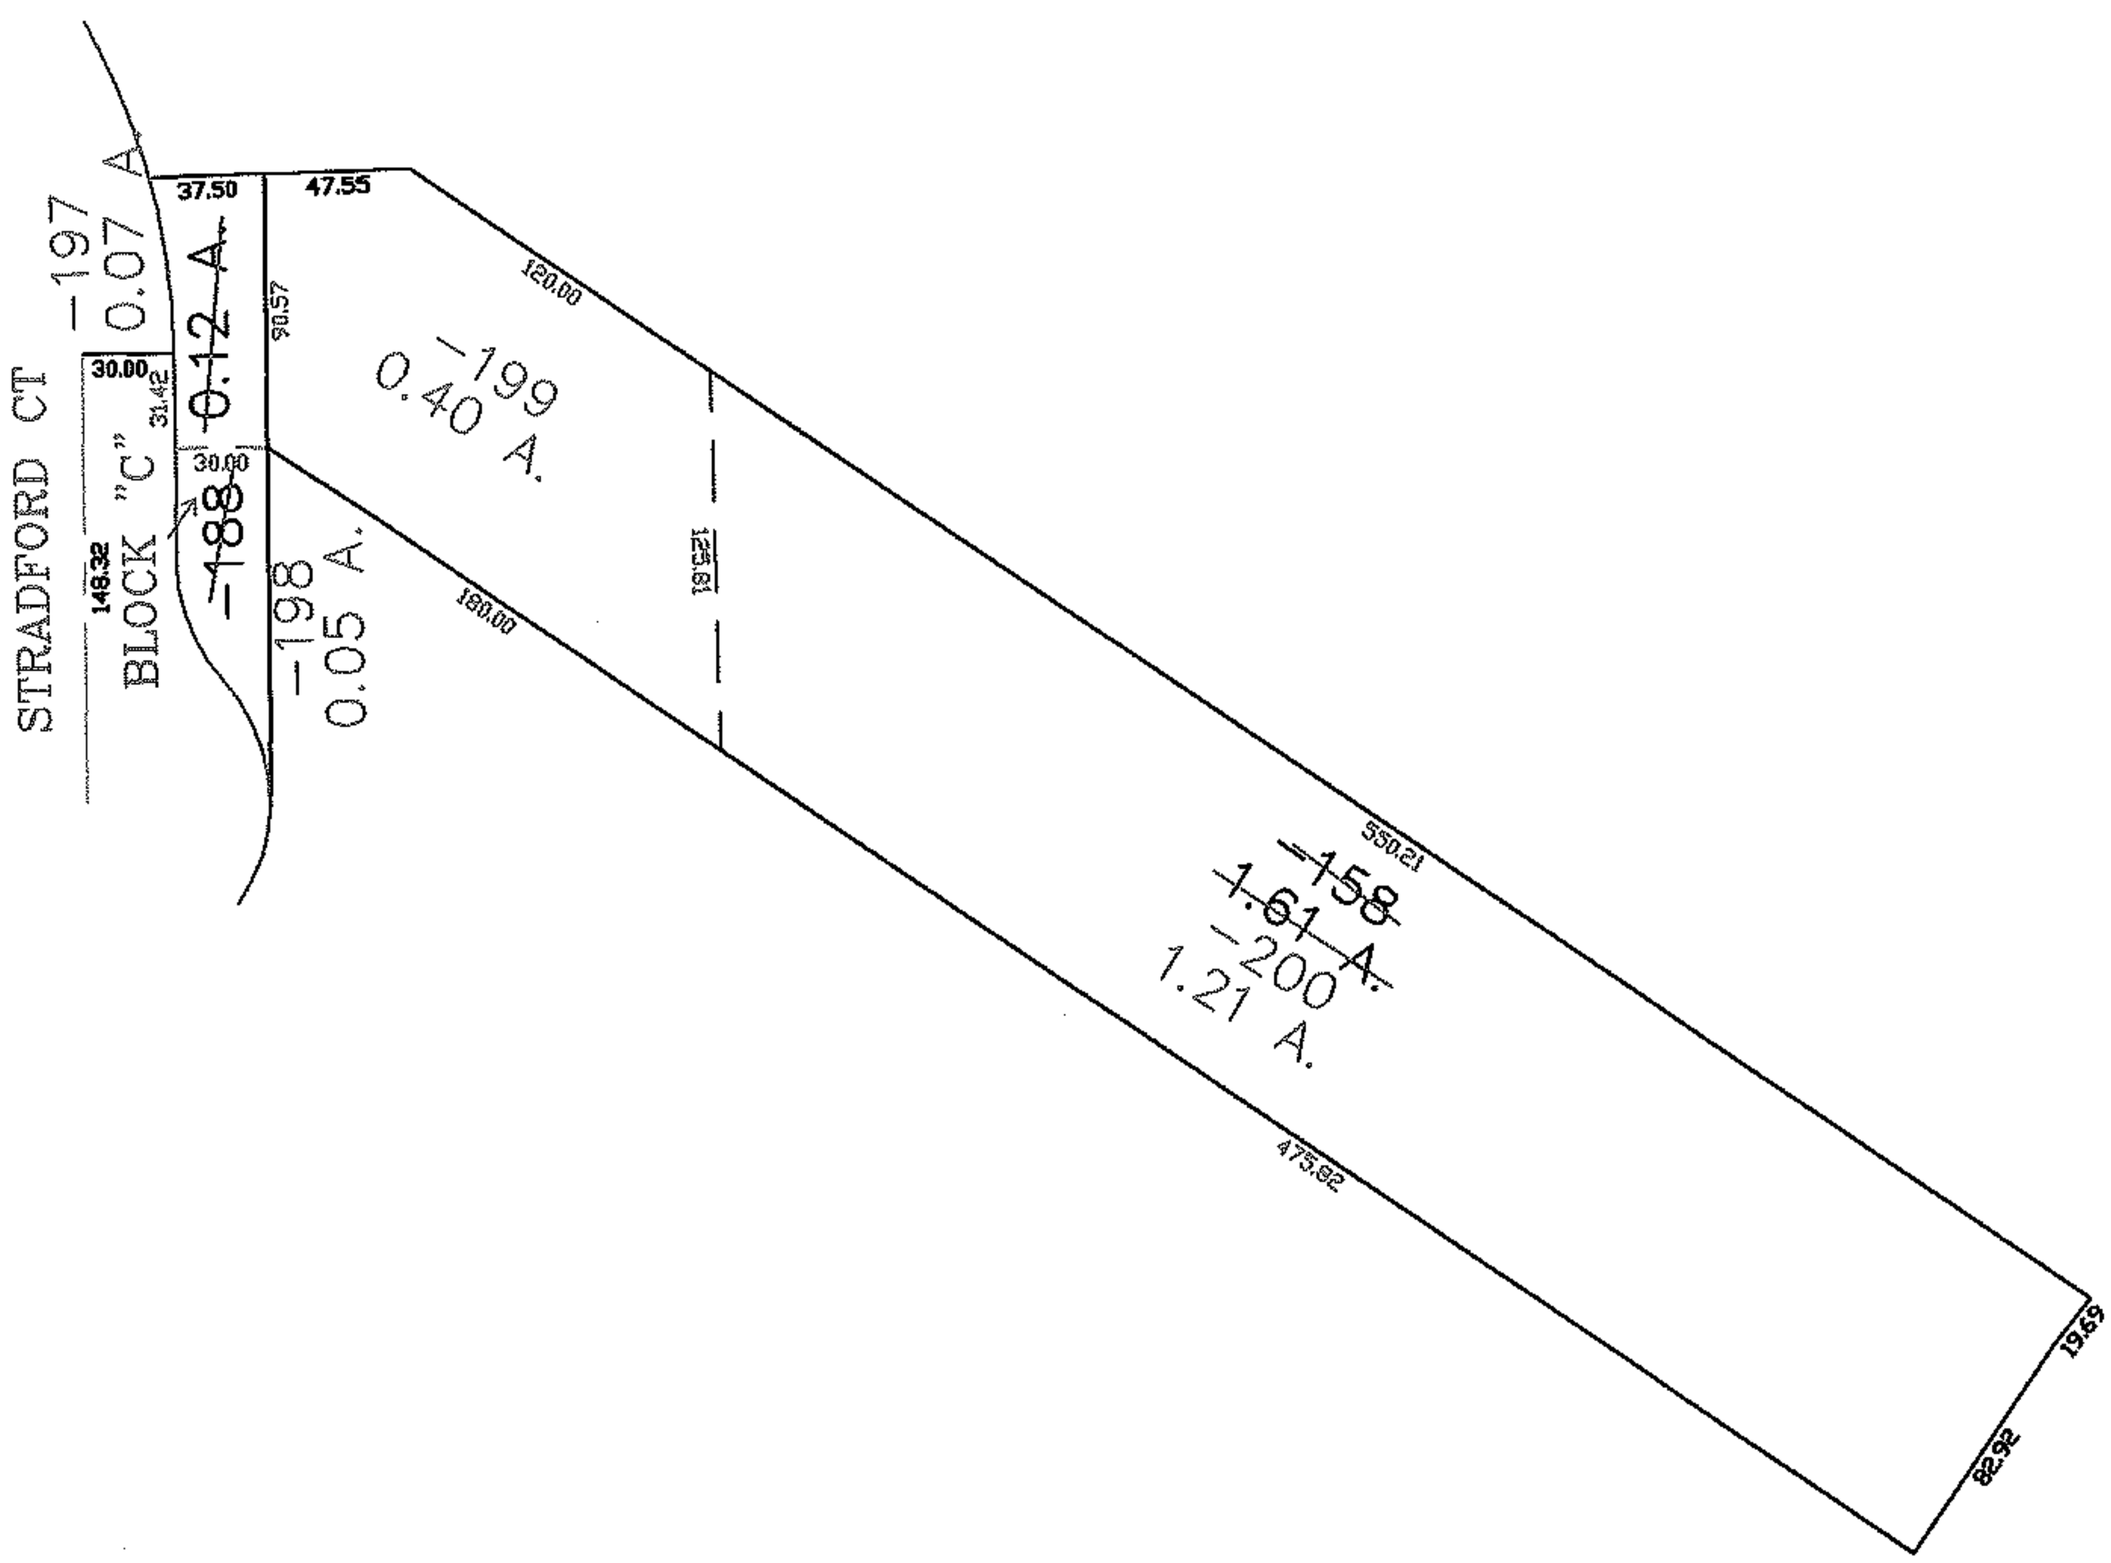

SPLITS/DEEDS PROCESSED

LORAIN COUNTY TAX MAP DEPARTMENT
226 MIDDLE AVE. ELYRIA, OHIO

SURVEYED BY: TERIN J KAMINSKI

CLOSURE: 0.00 : 10,000

MAP PAGE(S): 07-00-006-B

APPROVED BY: JAH DATE: 5-3-06

SCALE: 1"= 100 PRIOR INSTRUMENT: 20000681807